IREDELL COUNTY HEALTH DEPARTMENT

STATESVILLE 704-878-5305 MOORESVILLE 704-664-5281

IMPROVEMENT PERMIT / CERTIFICATE OF COMPLETION / OPERATION PERMIT / EXISTING SYSTEM INSPECTION

PROPERTY DESCRIPTION NO 2266A DATE 3-12-96 TAX MAP NO 176-A-72 Watershed [illegible] No

OWNER OR CONTRACTOR TINA CARD PHONE Business Home

ADDRESS C/O COUNTRY VILLAGE MHP / DAVID & SHIRLEY MORGAN

LOCATION US 21 N TR POWELL, TL KENNESAW TR WHITE DEER LANE, 1ST LOT ON RIGHT

SUBDIVISION COUNTRY VILLAGE BLOCK / SECTION LOT 9 LOT AREA LIMITED SITE CLASS PS DESIGN FLOW 360' LTAR EXISTING

Septic Tank: EXISTING Gallons: STB Date

Pump Tank: Gallons: PT Date

Pump Make: Model Serial No

Nitrification Field: No Fields Square Feet Linear Feet EXISTING

No Lines Trench Width Max Trench Bottom Depth Gravel Depth

New System Repair System Type CONV. GRAVITY

System Description

Repair System Description

Maintenance Agreement Required Yes ✓ No

House/Mod Home No Bedrooms 3

✓ Mobile Home No Bathrooms 2

Business No Employees

Other

Slab ✓ Crawl Space Basement w/plumbing Basement wo/plumbing


Water Supply: Individual ✓ Community Public

Comments:

Comments KEEP MH MINIMUM 5' FROM SYSTEM

INITIAL SITE SKETCH

AS BUILT SKETCH

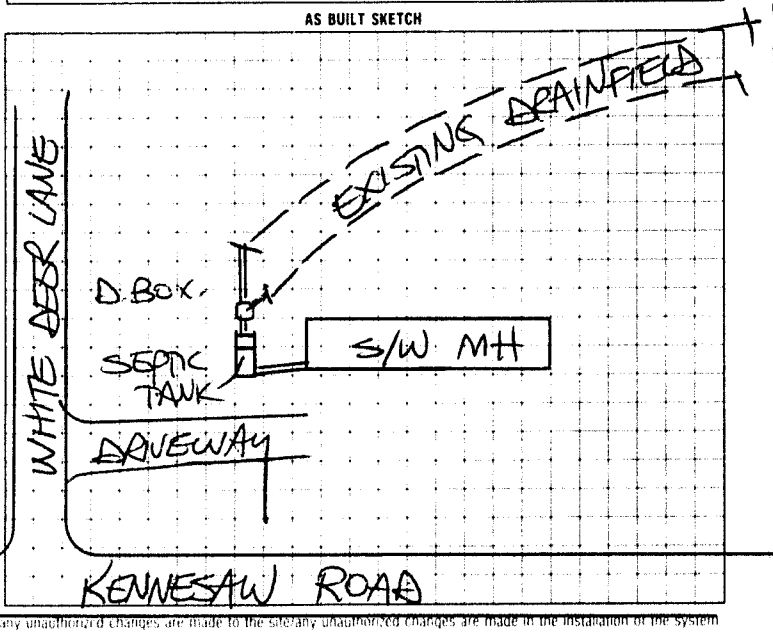

I understand that this permit can be suspended or revoked if any false information is supplied toward securing the permit, any unauthorized changes are made to the site, any unauthorized changes are made in the installation of the system

Signed

Improvement Permit by date

Existing System Inspection by STEVE HODRICK date 3-12-96

Installed by

Certificate of Completion by date

Operation Permit by date

HEALTH DEPT COPY WHITE INSPECTION COPY (FINAL) GREEN OWNER COPY (FINAL) YELLOW INSPECTION COPY (INITIAL) PINK OWNER COPY (INITIAL) GOLD