IREDELL COUNTY HEALTH DEPARTMENT - *ENVIRONMENTAL HEALTH* ☑ STATESVILLE OFFICE 704-878-5305 ☐ MOORESVILLE OFFICE 704-664-5281

IMPROVEMENT PERMIT / AUTHORIZATION TO CONSTRUCT / OPERATION PERMIT / EXISTING SYSTEM INSPECTION

PERMIT # 17682 PIN # 4881294360 DATE 6-11-12

OWNER Carl Benge II APPLICANT: Oakwood Mobile Homes PHONE: Home/Cell # 828-464-8715 Business # N/A

SITE ADDRESS 538 Kennesaw Rd. OWNER / APPLICANT ADDRESS 1265 US Hwy 70 Hickory NC

SITE DIRECTIONS US 21 N, R on Mayberry Rd, L on Kennesaw Rd, Property on Right

SUBDIVISION N/A BLOCK / SECTION N/A LOT # N/A LOT AREA 3.0 acres DESIGN FLOW 480gpd L.T.A.R. 0.25

Septic Tank Existing Gallons: STB ____ Date ____
Pump Tank ____ Gallons: P T ____ Date ____
Pump Make ____ Model ____ Serial # ____
No. Nitrification Fields: 1 No. Lines 2 Linear Feet 160'
Trench Width 36" Max. Trench Bottom Depth 36"

☐ New System ☐ Repair ☑ Expansion System Type I (II) III IV V VI
System Description: Conventional - gravity
Repair System Description: Conventional - gravity
Maintenance Agreement Required ☐ YES ☑ NO
Gravel Depth 12" ☑ GRAVITY ☐ PRESSURE


☑ Residence No. Bedrooms 4
☐ Business No. Persons ____
☐ Other No. Employees ____
☐ Slab ☐ Crawl Space
☐ Basement w/plumbing ☐ Basement w/o plumbing

Water Supply: ☑ Private ☐ Public ☐ Community


Comments / Conditions - Add 2 80' conventional lines on Contour with serial distribution to existing Septic system. An accepted system may also be installed.

- 25% Reduction system installed Quick 4

INITIAL SITE SKETCH

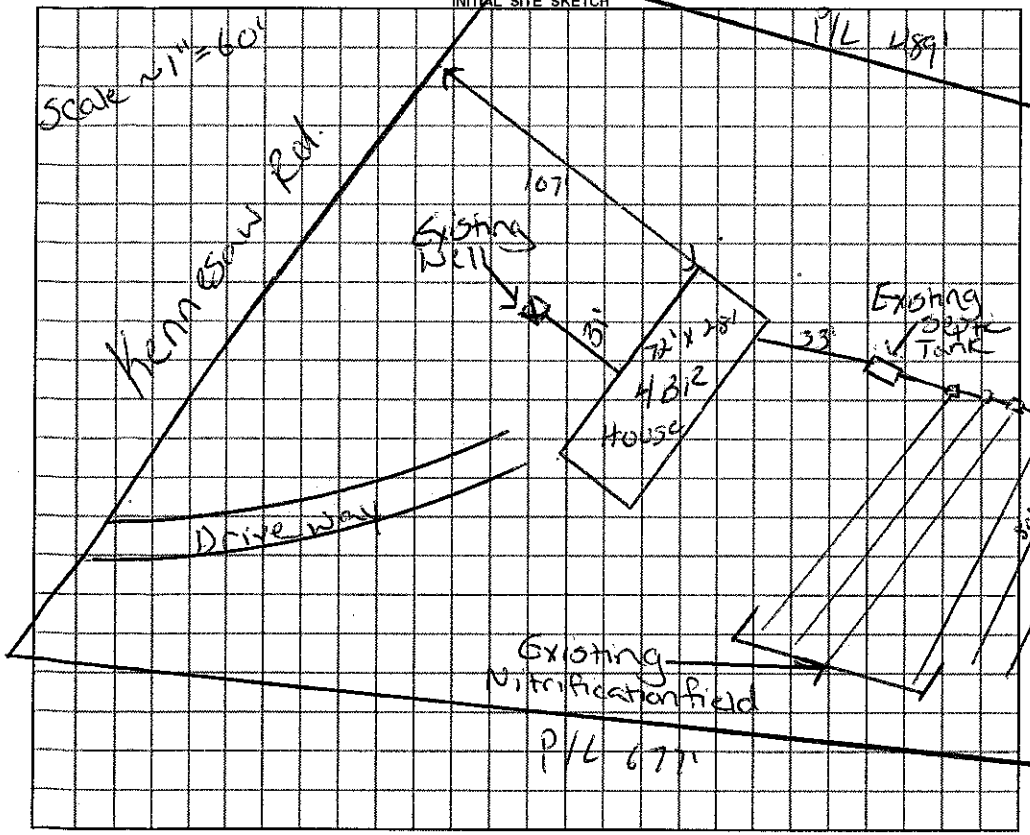

AS BUILT SKETCH

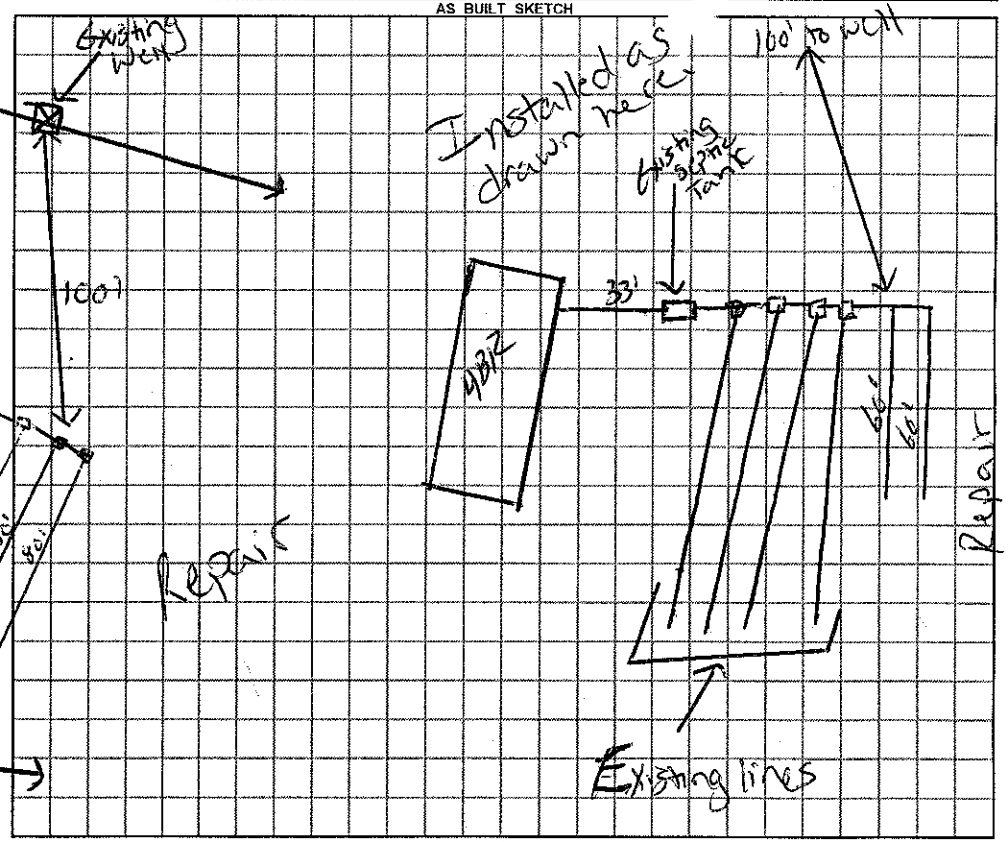

Permit can be suspended or revoked if any false information is supplied toward securing the permit / any unauthorized changes are made to the site / any unauthorized changes are made in the installation of the system.

☐ ***IMPROVEMENT PERMIT*** *with plat valid without expiration.* ☑ ***IMPROVEMENT PERMIT*** *with plat valid without expiration. site plan valid 60 mo.* ☑ ***AUTHORIZATION TO CONSTRUCT*** valid for period equal to IMPROVEMENT PERMIT--not to exceed 60 mo.

Owner / Applicant Signature: [signature] Date 6/11/12 Installed by: Shawn Allen

IMPROVEMENT PERMIT by: Justin Henderson REHS Date 6-11-12 OPERATION PERMIT by: Justin Henderson REHS Date 6-27-17

AUTHORIZATION TO CONSTRUCT by: Justin Henderson REHS Date 6-11-12 Existing System Inspected by: ____ REHS Date ____

YOU SHOULD CONTACT A LOCATOR SERVICE PRIOR TO ANY EXCAVATION

White Copy – Environmental Health YELLOW COPY (Final) Owner / Applicant PINK COPY (Initial) Owner / Applicant