IREDELL COUNTY HEALTH DEPARTMENT

STATESVILLE 704-878-5305 MOORESVILLE 704-664-5281

IMPROVEMENT PERMIT / AUTHORIZATION TO CONSTRUCT / OPERATION PERMIT / EXISTING SYSTEM INSPECTION

PERMIT# 080648 PIN# 4881 29 5542 DATE 4-23-99

OWNER OR CONTRACTOR A-1 MOBILE HOMES PHONE: Business 873-1014 Home

ADDRESS 590 MOCKSVILLE HWY, STATESVILLE NC 28677

LOCATION US 21 NORTH, TR MAYBERRY RD, TL KENNESAW ROAD, 2ND ON RIGHT PAST WHITE DEER LANE

SUBDIVISION BLOCK / SECTION LOT LOT AREA 0.690 ACRE SITE CLASS PS DESIGN FLOW 240 L.T.A.R. 0.20 GAD/FT²

Septic Tank: 1000 Gallons; STB 620 Date 3-13-99
Pump Tank: Gallons; PT Date
Pump Make: Model Serial No.
Nitrification Field: No Fields 1 Square Feet EQ. TO 1200 Linear Feet 300+
No Lines SIX Trench Width Max Trench Bottom Depth

☑ New System ☐ Repair System Type: I, II, III, IV, V, VI
System Description: 25% REDUCTION GRAVITY
Repair System Description: 50% REDUCTION PUMP
Maintenance Agreement Required: ☐ Yes ☑ No


☐ House/Mod. Home ☑ Mobile Home ☐ Business ☐ Other
No. Bedrooms 3 No. Bathrooms 2 No. Employees
☐ Slab ☑ Crawl Space ☐ Basement w/plumbing ☐ Basement wo/plumbing

Water Supply: ☑ Individual ☐ Public ☐ Community WELL


Comments/Conditions: (1) INSTALL 48 CHAMBERS OR THRM H.D.S. SECTIONS IN SIX EQUAL LENGTH LINES (2) KEEP SYSTEM MAXIMUM FEASIBLE DISTANCE (80 FEET) FROM WELLS

Comments/Conditions: SEPTIC TANK WITH RISERS INSTALLED USING "POLYLOK" FILTER

INITIAL SITE SKETCH

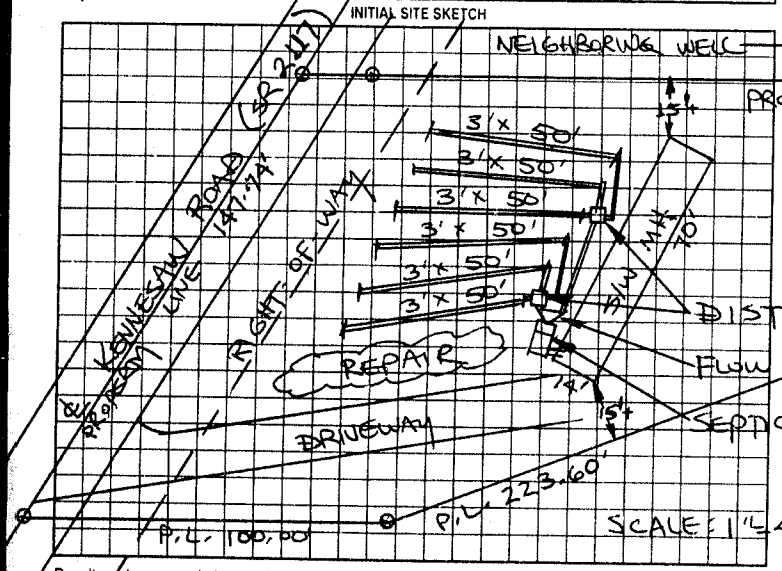

AS BUILT SKETCH

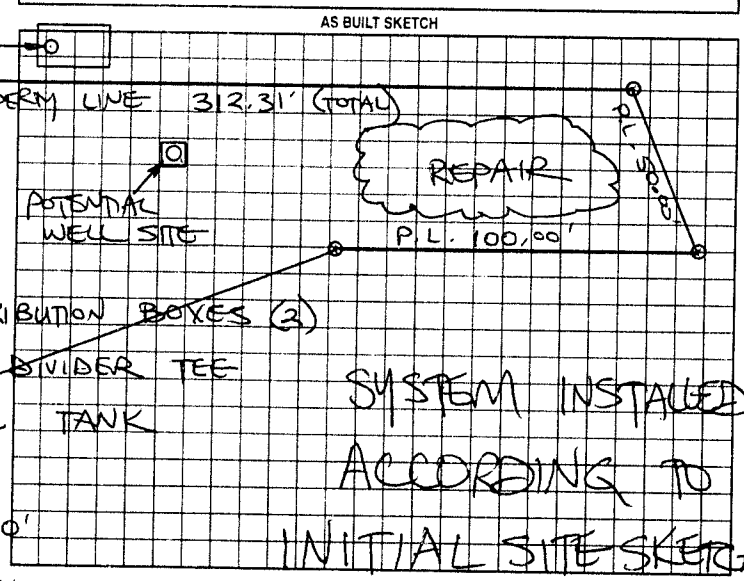

Permit can be suspended or revoked if any false information is supplied toward securing the permit/any unauthorized changes are made to the site/any unauthorized changes are made in the installation of the system. Improvement Permit with plat valid without expiration. Improvement Permit with site plan valid for sixty months. Authorization to Construct is valid for a period equal to that of Improvement Permit – not to exceed sixty months.

Signed date

Improvement Permit by: STEVE HEDRICK date 4-23-99

Authorization to Construct by: STEVE HEDRICK date 4-23-99

Installed by: SAMMY REAVES

Operation Permit by: STEVE HEDRICK date 5-25-99

Existing System Inspection by: date

HEALTH DEPT COPY: WHITE OWNER COPY (FINAL) YELLOW OWNER COPY (INITIAL) PINK