THIS PERMIT VOIDS PREVIOUS ISSUED 2-24-97

REBELL COUNTY HEALTH DEPARTMENT

STATESVILLE 704-878-5305 MOORESVILLE 704-664-5281

IMPROVEMENT PERMIT / AUTHORIZATION TO CONSTRUCT / OPERATION PERMIT / EXISTING SYSTEM INSPECTION

PERMIT# 080649 PIN# 4881 29 6450 DATE 4-23-99

OWNER OR CONTRACTOR A-1 MOBILE HOMES PHONE: Business 873-1014 Home

ADDRESS 590 MOCKSVILLE HWY, STATESVILLE NC 28677

LOCATION US 21 N, TR POWELL BRIDGE RD, TL KENNESAW ROAD, 1ST ON RIGHT PAST WHITE DEER LANE

SUBDIVISION BLOCK / SECTION LOT LOT AREA 0.887 ACRE SITE CLASS PS DESIGN FLOW 240 L.T.A.R. 0.30 GPD/FT²

Septic Tank: 1000 Gallons; STB 620 Date 3-13-99
Pump Tank: Gallons; PT Date
Pump Make: Model Serial No.
Nitrification Field: No Fields 1 Square Feet 810 Linear Feet 270
No Lines THREE Trench Width 36" Max Trench Bottom Depth 36" Gravel Depth 12"

☑ New System ☐ Repair System Type: ☐ I ☐ II ☐ III ☐ IV ☐ V ☐ VI
System Description: CONVENTIONAL GRAVITY
Repair System Description: CONV. GRAVITY
Maintenance Agreement Required: ☐ Yes ☑ No


☐ House/Mod. Home ☑ Mobile Home ☐ Business ☐ Other
No. Bedrooms 2 No. Bathrooms 2 No. Employees
☐ Slab ☐ Crawl Space ☐ Basement w/plumbing ☐ Basement wo/plumbing

Water Supply: ☑ Individual ☐ Public ☐ Community
WELL


Comments/Conditions: KEEP SYSTEM MAXIMUM FEASIBLE DISTANCE FROM WELLS.

Comments/Conditions: ① SEPTIC TANK W/ RISERS INSTALLED USING "POLYLOK" FILTER.
② SYSTEM INSTALLED ACCORDING TO INITIAL SITE SKETCH.

INITIAL SITE SKETCH

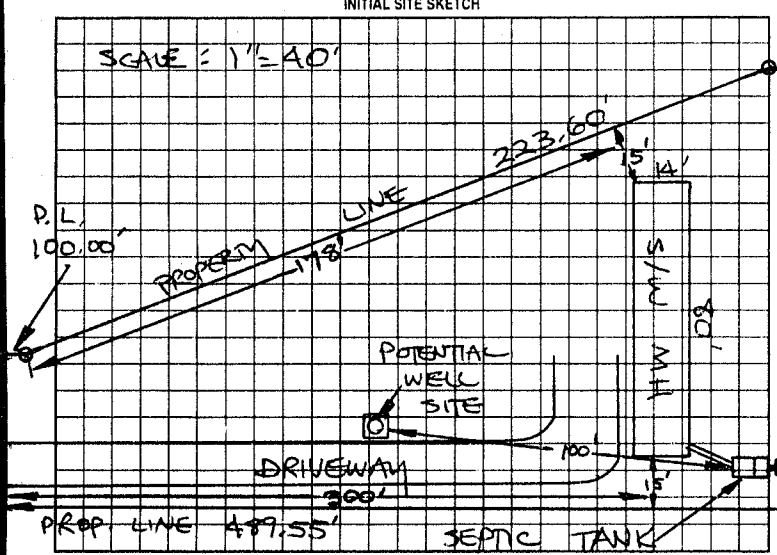

AS BUILT SKETCH

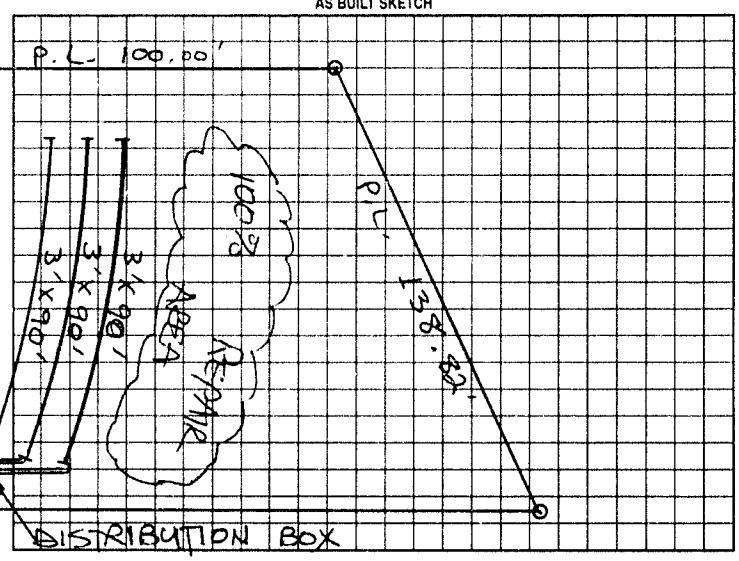

Permit can be suspended or revoked if any false information is supplied toward securing the permit/any unauthorized changes are made to the site/any unauthorized changes are made in the installation of the system. Improvement Permit with plat valid without expiration. Improvement Permit with site plan valid for sixty months. Authorization to Construct is valid for a period equal to that of Improvement Permit - not to exceed sixty months.

Signed: _____ date 4-26-99 Installed by: SAMMY REAVIS

Improvement Permit by: STEVE HEDRICK date 4-23-99 Operation Permit by: STEVE HEDRICK date 5-21-99

Authorization to Construct by: STEVE HEDRICK date 4-23-99 Existing System Inspection by: date

HEALTH DEPT COPY WHITE OWNER COPY (FINAL) YELLOW OWNER COPY (INITIAL) PINK