IREDELL COUNTY HEALTH DEPARTMENT — STATESVILLE 704-878-5305 — MOORESVILLE 704-664-5281

changes 9/16/09 3:00

IMPROVEMENT PERMIT / AUTHORIZATION TO CONSTRUCT / OPERATION PERMIT / EXISTING SYSTEM INSPECTION

PERMIT # 15442 PIN # ~~4881296907~~ 4881-29-6867 DATE 3-20-09

OWNER or APPLICANT Daniel Romero PHONE: Business Home: 704-546-2001

OWNER or APPLICANT ADDRESS 564 Kennesaw Rd Harmony 28634

LOCATION / DIRECTIONS 21 N. (R) Powell Bridge (R) Kennesaw on right past White ...

SUBDIVISION BLOCK / SECTION LOT # 2 LOT AREA 1.58 DESIGN FLOW 360 L.T.A.R. .25

Septic Tank 1000 Gallons: STB 760 Date 3-8-09
Pump Tank Gallons: PT Date
Pump Make Model Serial #
Nitrification Field No Fields No Lines 4 Linear Feet 360
Trench Width 36" Max. Trench Bottom Depth 36" Gravel Depth ND

☒ New System ☐ Repair ☐ Expansion System Type I II III IV V VI
System Description: 25% Gravity
Repair System Description: 25% Pump / Gravity
Maintenance Agreement Required ☐ YES ☒ NO
☐ GRAVITY ☐ PRESSURE


☒ Residence No. Bedrooms 3
☐ Business No. Persons
☐ Other No. Employees
☐ Slab ☐ Crawl Space
☐ Basement w/plumbing ☐ Basement w/o plumbing

Water Supply
☒ Private
☐ Public
☐ Community


Comments / Conditions
Rake - Limit Sidewalls

Comments / Conditions
Install on contour / Maintain all setbacks / Polylock Filter

INITIAL SITE SKETCH

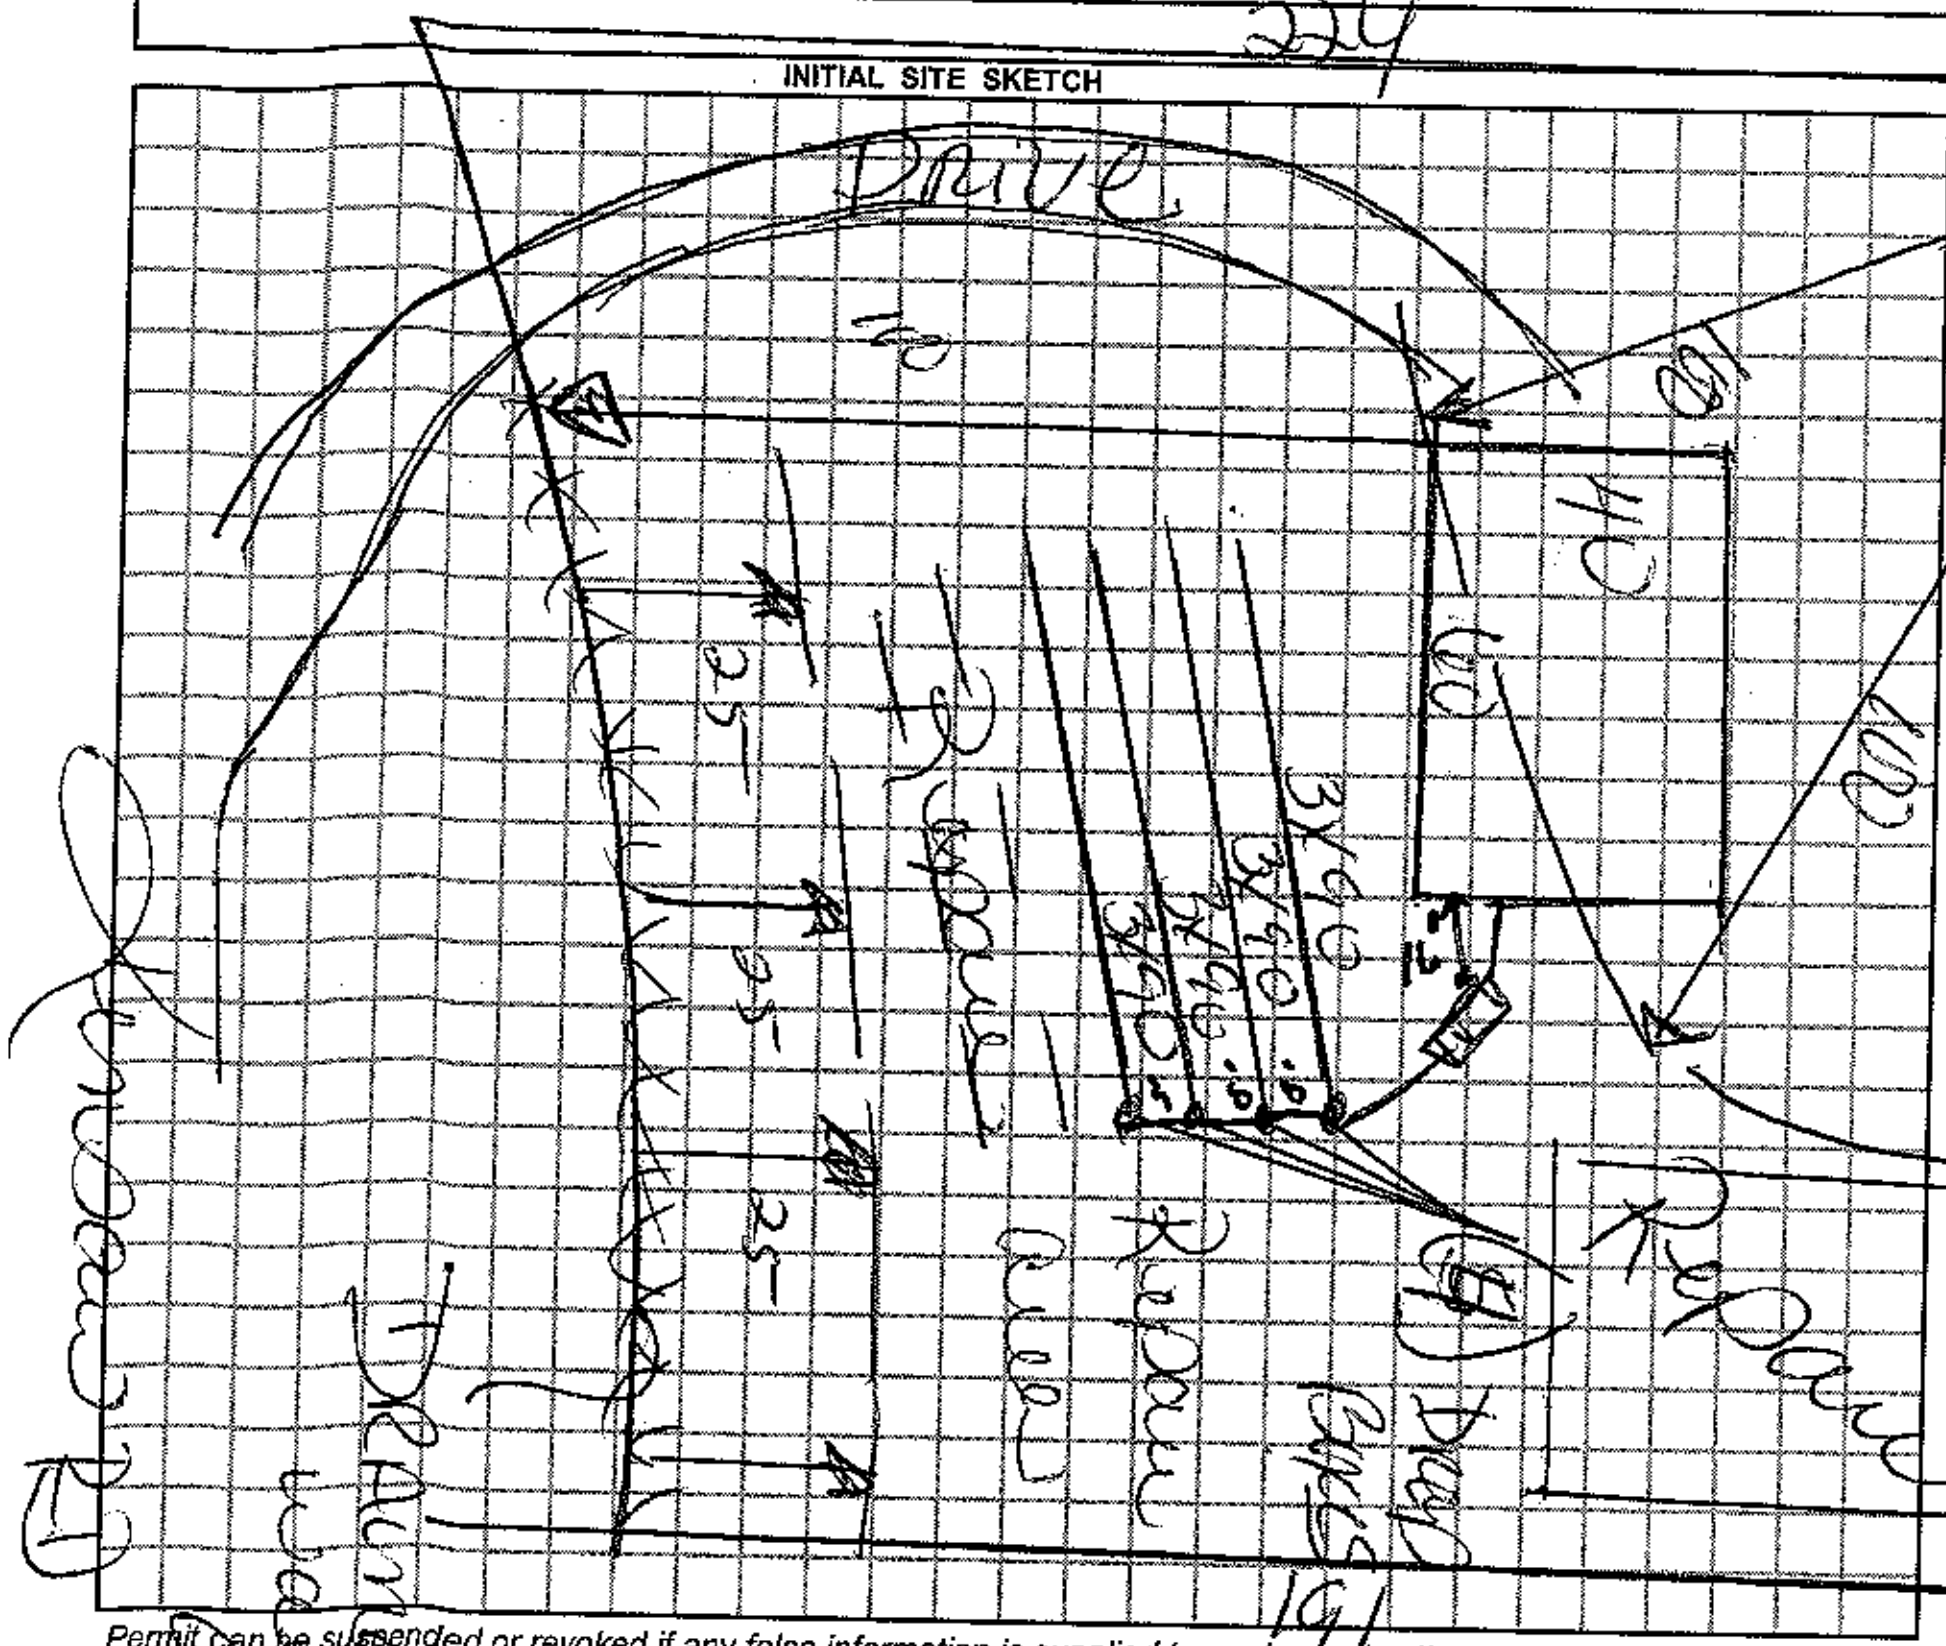

AS BUILT SKETCH

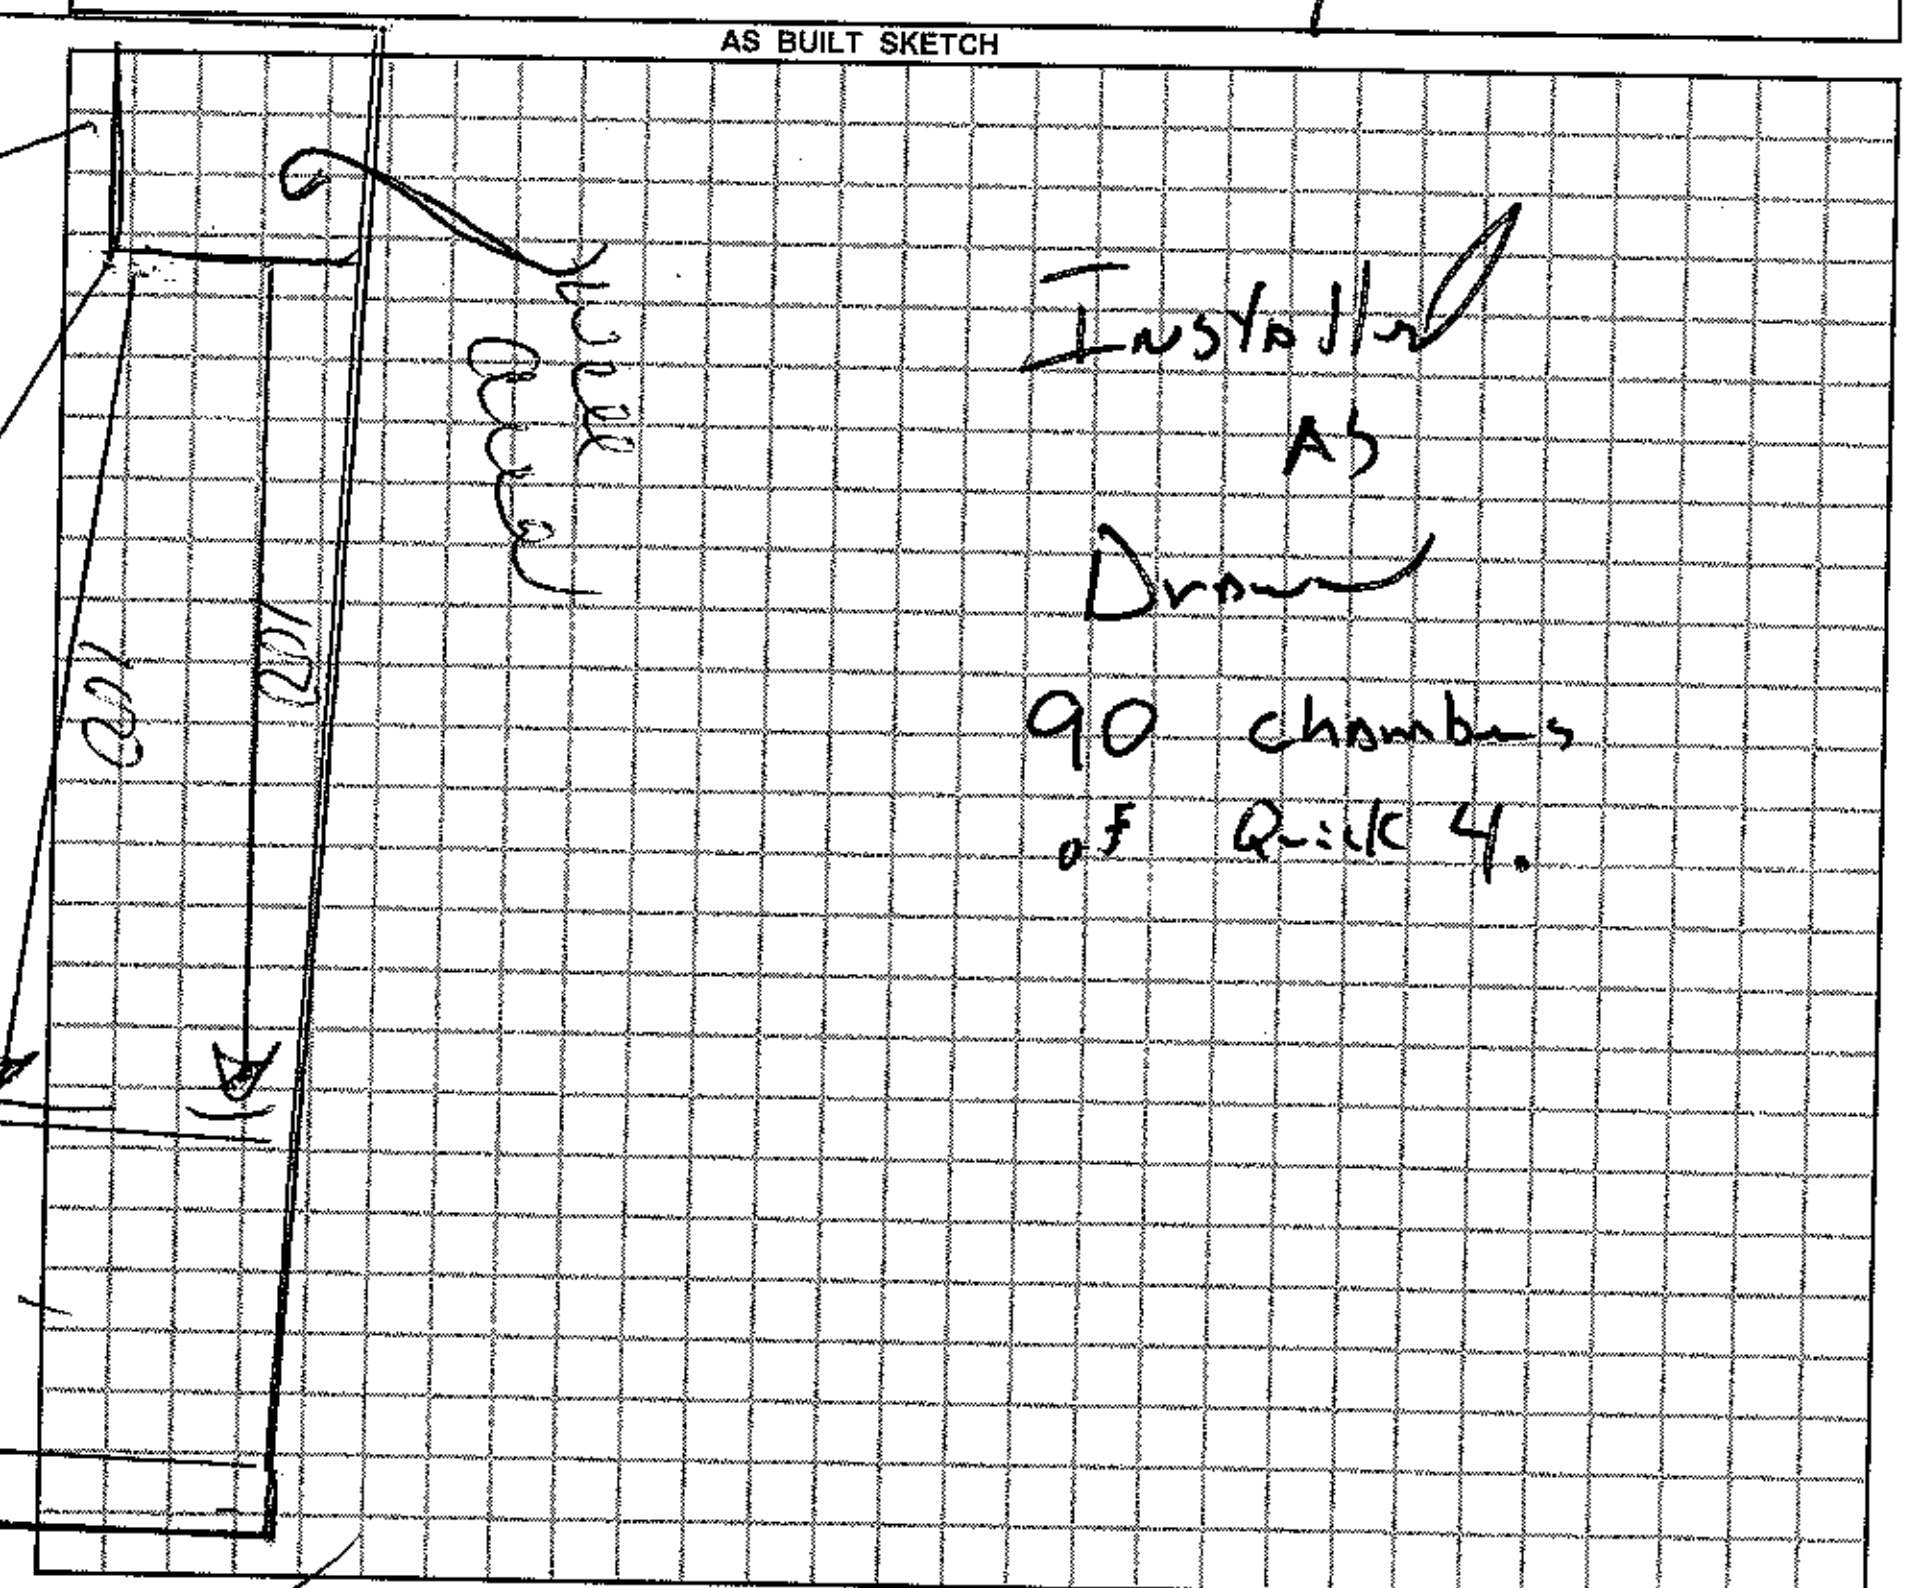

Permit can be suspended or revoked if any false information is supplied toward securing the permit / any unauthorized changes are made to the site / any unauthorized changes are made in the installation of the system.

☐ *IMPROVEMENT PERMIT w / plat valid without expiration* ☐ *IMPROVEMENT PERMIT w / site plan valid for 60 mos.* ☒ *AUTHORIZATION TO CONSTRUCT valid for period equal to IMPROVEMENT PERMIT-not to exceed 60 mo.*

Owner / Applicant Signature: Elizabeth Romero Date 3/23/09

Improvement Permit by: [signature] Cook Date 3-20-09

Authorization to Construct by: [signature] Cook Date 3-20-09

Installed by: Salmon's Grading & Hauling

Operation Permit by: [signature], R.S. Date: 25 August 09

Existing System Inspected by: Date:

YOU SHOULD CONTACT A LOCATOR SERVICE PRIOR TO ANY EXCAVATION.

WHITE COPY Environmental Health YELLOW COPY (Final) Owner / Applicant PINK COPY (Initial) Owner / Applicant