IREDELL COUNTY HEALTH DEPARTMENT

STATESVILLE 704-878-5305 (C1) MOORESVILLE 704-664-5281

IMPROVEMENT PERMIT / AUTHORIZATION TO CONSTRUCT / OPERATION PERMIT / EXISTING SYSTEM INSPECTION

PERMIT# 115966 PIN# 4881-32-3091 DATE 10-15-03

OWNER OR CONTRACTOR TRAVIS & KIMBERLY IRELAND PHONE: Business Home 704-546-7689

ADDRESS 21 NORTH THRU HARMONY, L BUTLER MILL RD CROSS CREEK, 100 YARDS ON LEFT AT BOX # 611

LOCATION 611 BUTLER MILL RD HARMONY, NC 28634

SUBDIVISION BLOCK / SECTION LOT LOT AREA 3.64 AC SITE CLASS. PS DESIGN FLOW 360 L.T.A.R. .3

Septic Tank: 1000 Gallons; STB 1007 Date 9-19-03
Pump Tank: Gallons; PT Date
Pump Make: Model Serial No.
Nitrification Field: No Fields 1 Square Feet 1200' Linear Feet 400'
No Lines 4 Trench Width 36" Max Trench Bottom Depth 36" Gravel Depth 12"

[X] New System [ ] Repair System Type: I, [II], III, IV, V, VI
System Description: CONV GRAV
Repair System Description: PUMP CONV
Maintenance Agreement Required: [ ] Yes [X] No


[X] House/Mod. Home No. Bedrooms 3
[ ] Mobile Home No. Bathrooms 2
[ ] Business No. Employees
[ ] Other
[ ] Slab [X] Crawl Space [ ] Basement w/plumbing [ ] Basement wo/plumbing

Water Supply: [X] Individual [ ] Public [ ] Community


Comments/Conditions: (1) GRADE TO 56' OFF P/L, AT 56' LEAVE AT NATURAL GRADE. MET CONTRACTOR & DISCUSSED THIS WITH HIM. THE NATURAL GRADE AREA DOWNHILL WILL NEED TO BE UNALTERED BECAUSE THIS IS THE

Comments/Conditions: DRAINLINE AREA, (2) MAINTAIN SETBACKS (3) SYSTEM & WELL IS PLACED (COMPLETELY), (4) KEEP WELL 100' AWAY FROM SYSTEM

INITIAL SITE SKETCH

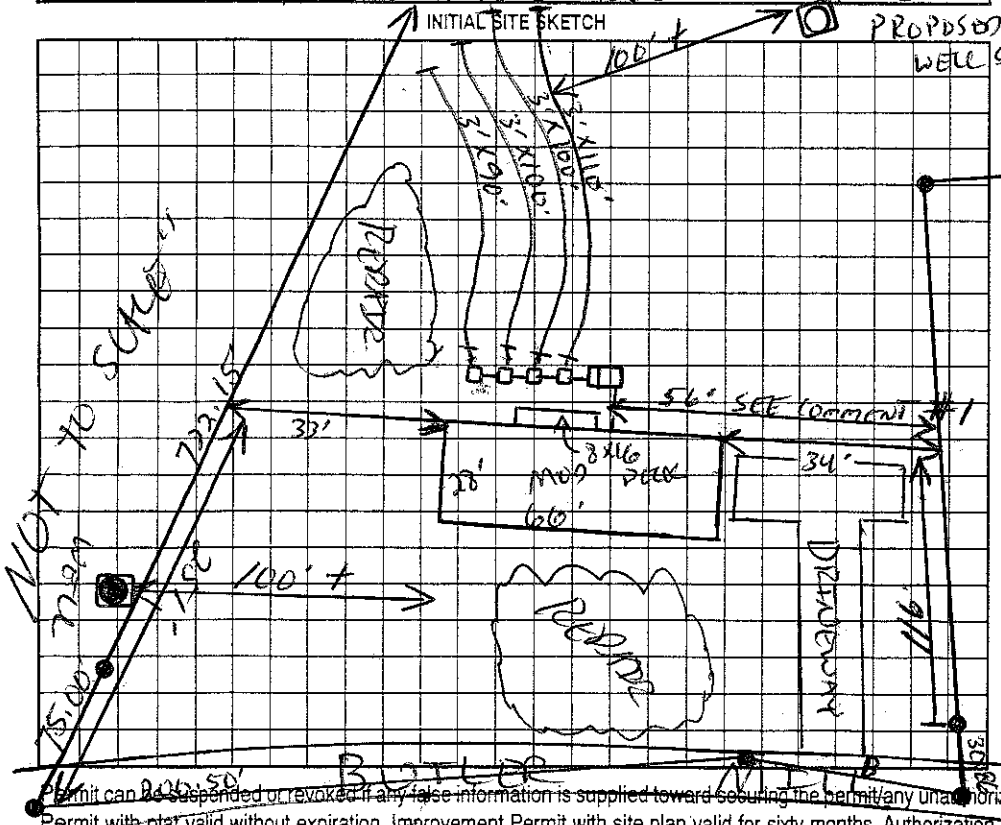

AS BUILT SKETCH

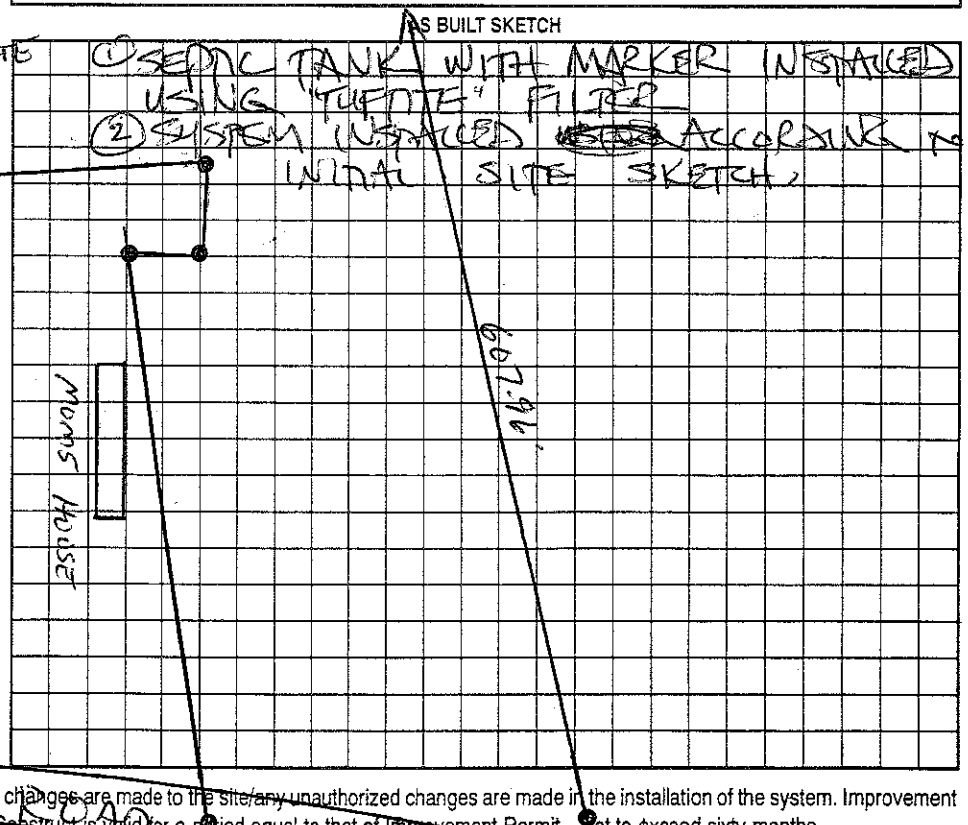

Permit can be Suspended or revoked if any false information is supplied toward securing the permit/any unauthorized changes are made to the site/any unauthorized changes are made in the installation of the system. Improvement Permit with plat valid without expiration. Improvement Permit with site plan valid for sixty months. Authorization to Construct is valid for a period equal to that of Improvement Permit – not to exceed sixty months.

Signed: Ken Welter date 10/15/03 Installed by: TOMMY CONTRERAS

Improvement Permit by: date 10/15/03 Operation Permit by: STEVE HENDRICK date 11-21-03

Authorization to Construct by: date 10-15-03 Existing System Inspection by: date

HEALTH DEPT. COPY: WHITE OWNER COPY (FINAL): YELLOW OWNER COPY (INITIAL): PINK