IREDELL COUNTY HEALTH DEPARTMENT

STATESVILLE 704-878-5305 MOORESVILLE 704-664-5281

IMPROVEMENT PERMIT / CERTIFICATE OF COMPLETION / OPERATION PERMIT / EXISTING SYSTEM INSPECTION

PROPERTY DESCRIPTION NO. 18175 DATE 4/5/94 TAX MAP NO. 17C-A-19 Watershed: ☐ Yes ☑ No

OWNER OR CONTRACTOR BARRY WILDER PHONE: Business Home 5462314

ADDRESS P.O. BOX 388, HARMONY NC 28634

LOCATION US 21 N, TR TOMLINSON, CONTINUE BUTLER MILL ON (L) AT ROSWELL INTERSECTION

SUBDIVISION BLOCK / SECTION LOT LOT AREA ~400'x440' SITE CLASS: PS DESIGN FLOW 360 L.T.A.R. 0.35 GPD/FT2

Septic Tank: 1000 Gallons: STB 620 Date 1/4/94

Pump Tank: ~~DOSING~~ Gallons: ~~PUMP~~ Date

Pump Make: Model Serial No.

Nitrification Field: No Fields 1 Square Feet 1035 Linear Feet 345'

No Lines 3 Trench Width 36" Max Trench Bottom Depth 24" Gravel Depth 12"

☑ New System ☐ Repair System Type: I, II, III, IV, V, VI

System Description: CONV. GRAVITY

Repair System Description: CONV. GRAVITY

Maintenance Agreement Required: ☐ Yes ☑ No

☑ House/Mod. Home No. Bedrooms 3

☐ Mobile Home No. Bathrooms 2

☐ Business No. Employees

☐ Other


☐ Slab ☑ Crawl Space ☐ Basement w/plumbing ☐ Basement wo/plumbing

Water Supply: ☑ Individual ☐ Community ☐ Public WELL


Comments: (1) KEEP SYSTEM MINIMUM 5' FROM HOME, 10' FROM PROPERTY LINE, 100' FROM WELL. (2) INSTALL LINES WITH CONTOUR OF GROUND, NO DEEPER THAN 24", 9' APART ON CENTER

Comments:

INITIAL SITE SKETCH

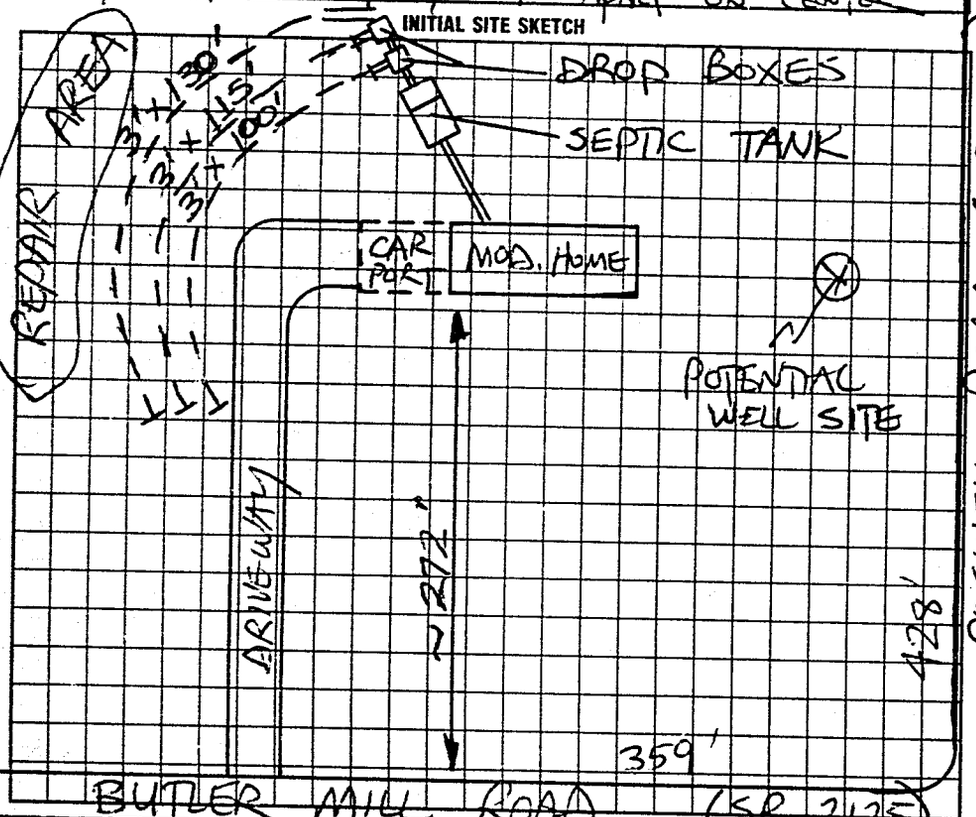

AS BUILT SKETCH

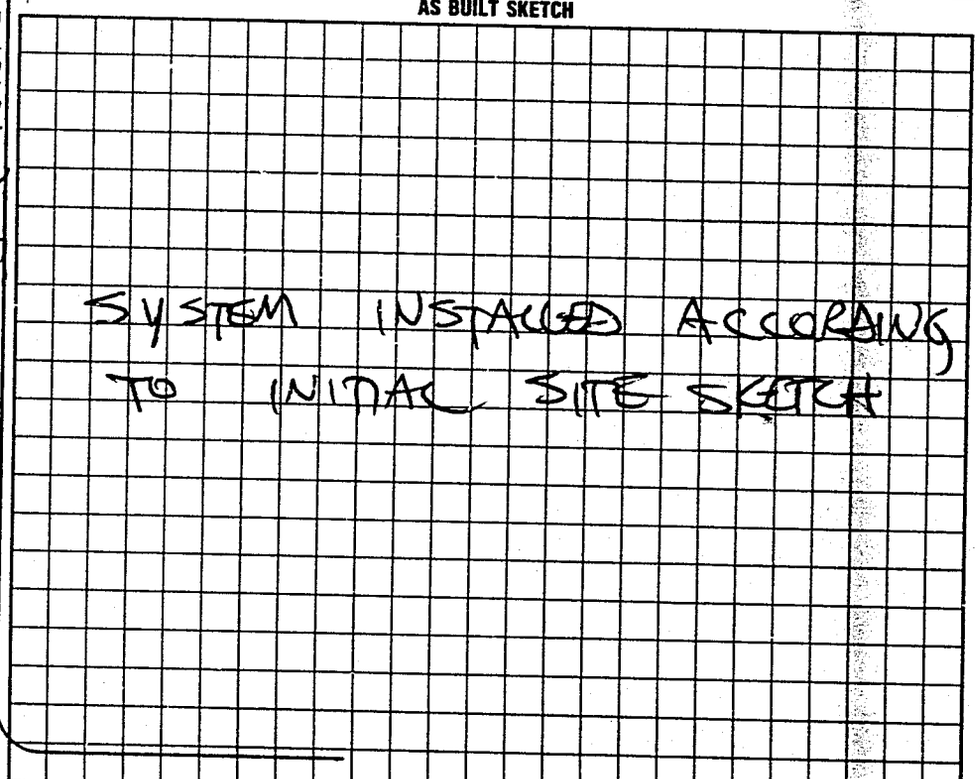

I understand that this permit can be suspended or revoked if any false information is supplied toward securing the permit/any unauthorized changes are made to the site/any unauthorized changes are made in the installation of the system. Improvement Permit is valid for 60 months from date of issuance.

Signed: X Barry W. Wilder

Improvement Permit by: STEVE HEDRICK date 4/5/94

Existing System Inspection by: date

Installed by: SAMMY REAVIS

Certificate of Completion by: STEVE HEDRICK date 4/19/94

Operation Permit by: date

HEALTH DEPT. COPY: WHITE INSPECTION COPY (FINAL): GREEN OWNER COPY (FINAL): YELLOW INSPECTION COPY (INITIAL): PINK OWNER COPY (INITIAL): GOLD