IREDELL COUNTY HEALTH DEPARTMENT

Statesville Phone TR 3-7271 Mooresville Phone NO 3-1271

PERMIT TO INSTALL SEPTIC TANK

Permit No. 377 Permit Date Nov. 6 1970

Owner MR SIDNEY IRELAND Address HARMONY, N.C. Rt 2

Installed By LACKEY BROS. Address STONY POINT, N.C.


Location of Property HIGHWAY 21 NORTH PAST HARMONY TURN RIGHT ON ROAD # 2120 CROSS CREEK TURN RIGHT ON ROAD # 2124 2ND HOUSE ON LEFT.

Tank		Capacity		Length of Lines		Fixtures	
Block	( )	1000	(✓)	225'	(✓)	No. of Baths	(1)
Precast	(✓)	1250	( )	250'	( )	Dishwasher	( )
		1500	( )	Other		Garbage Grdr.	( )
		Other				Other	

NOTIFY HEALTH DEPARTMENT AT LEAST EIGHT HOURS BEFORE TANK IS TO BE INSPECTED.

Final Inspection Nov. 6 1970 Approved (✓) Disapproved ( )

Remarks

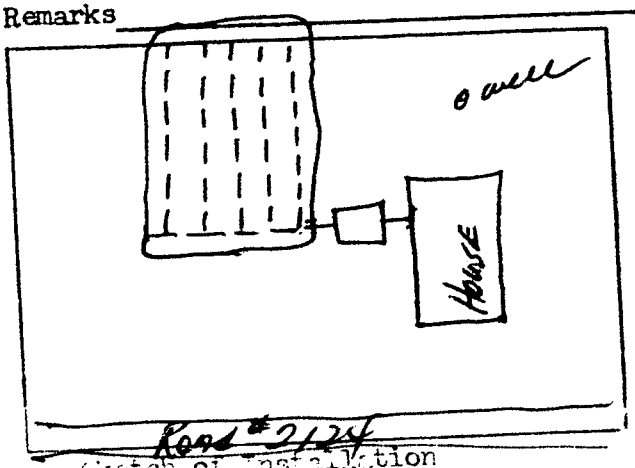

Sketch of Installation

Glenn Todd

Sanitarian