IREDELL COUNTY HEALTH DEPARTMENT

STATESVILLE 704-878-5305 MOORESVILLE 704-664-5281

IMPROVEMENT PERMIT / AUTHORIZATION TO CONSTRUCT / OPERATION PERMIT / EXISTING SYSTEM INSPECTION

PERMIT# 093525 PIN# 4881 75 2916 DATE 12-29-00

OWNER OR CONTRACTOR JAMES EDWARD TAYLOR PHONE: Business Home 546-5951

ADDRESS 559 POWELL BRIDGE RD HARMONY NC 28634

LOCATION US 21 NORTH, TR POWELL 'BRIDGE ROAD', CROSS 2ND BRIDGE 1ST MH ON LEFT AT BOX #559

SUBDIVISION BLOCK / SECTION LOT LOT AREA 2.63 ACRES SITE CLASS. PS' DESIGN FLOW 360 L.T.A.R. 0.30 GPD/FT²

Septic Tank: EXISTING Gallons; STB 620 Date 5-11-95
Pump Tank: Gallons; PT Date
Pump Make: Model Serial No.
Nitrification Field: No Fields 1 Square Feet 390 Linear Feet 130
No Lines TWO Trench Width 36" Max Trench Bottom Depth 36" Gravel Depth 12"

☑ New System ☐ Repair System Type: I (II) III, IV, V, VI
System Description: CONVENTIONAL GRAVITY
Repair System Description: CONV GRAVITY
Maintenance Agreement Required: ☐ Yes ☑ No


☐ House/Mod. Home No. Bedrooms 3
☑ Mobile Home No. Bathrooms 2
☐ Business No. Employees
☐ Other
☐ Slab ☑ Crawl Space ☐ Basement w/plumbing ☐ Basement wo/plumbing

Water Supply: ☑ Individual ☐ Public ☐ Community
WELL

Comments:/Conditions: INSTALL TWO NEW DROP BOXES AS SHOWN TO PROVIDE SERIAL DISTRIBUTION INTO TWO NEW DRAINLINES OF 3'x70' AND 3'x60'

Comments:/Conditions: ① HOUSE NOT ON SITE AT TIME OF FINAL INSPECTION. ② NO CUTTING OR FILLING OVER DRAINFIELDS AREAS ③ KEEP ALL DRAINS AWAY FROM DRAINFIELD AND REPAIR AREAS

INITIAL SITE SKETCH

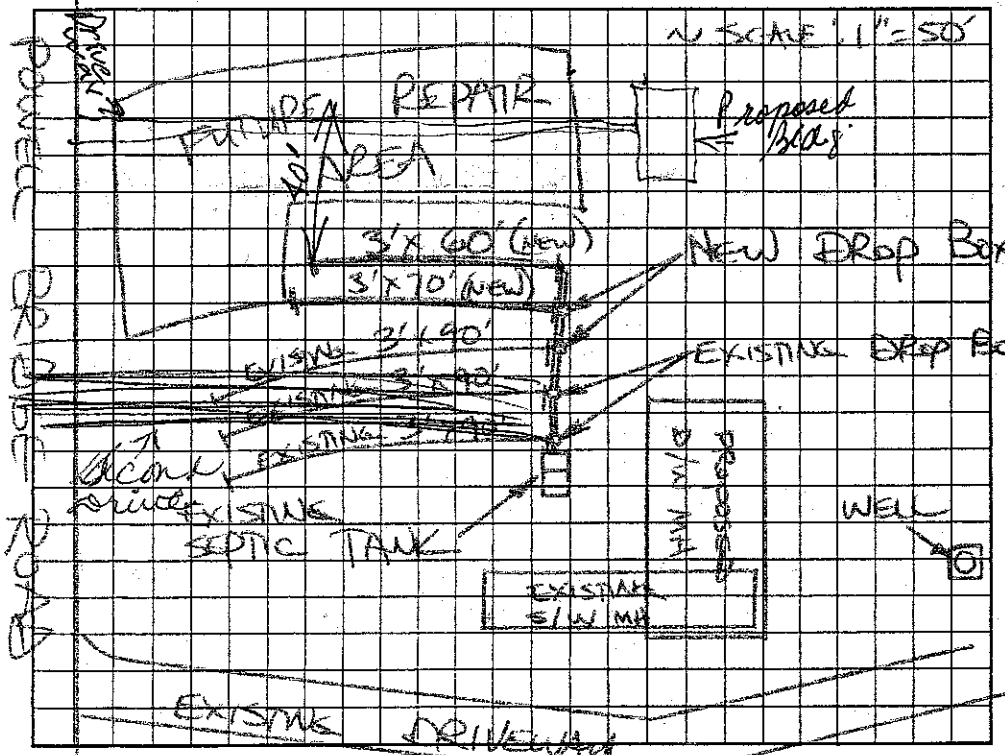

AS BUILT SKETCH

INSTALLED AS DESIGNED ON A/C.

The proposed out building addition does not appear to impact the existing septic system.
**NOTE: Bldg. must be 10' off last septic line
R.S.
Date: 24 June 09
ICHD-Environmental Health Division

Permit can be suspended or revoked if any false information is supplied toward securing the permit/any unauthorized changes are made to the site/any unauthorized changes are made in the installation of the system. Improvement Permit with plat valid without expiration. Improvement Permit with site plan valid for sixty months. Authorization to Construct is valid for a period equal to that of Improvement Permit – not to exceed sixty months.

Signed: James Taylor date 1-9-10
Improvement Permit by: STEVE HENDRICK date 12-29-00
Authorization to Construct by: STEVE HENDRICK date 12-29-00

Installed by: SAMMY REAVIS
Operation Permit by: date 1/25/01
Existing System Inspection by: date

HEALTH DEPT. COPY: WHITE OWNER COPY (FINAL): YELLOW OWNER COPY (INITIAL): PINK