IREDELL COUNTY HEALTH DEPARTMENT

STATESVILLE 704-878-5305 MOORESVILLE 704-664-5281

IMPROVEMENT PERMIT / AUTHORIZATION TO CONSTRUCT / OPERATION PERMIT / EXISTING SYSTEM INSPECTION

PERMIT# REPAIR PIN# 4881 83 7011 DATE 12-19-01

OWNER OR CONTRACTOR DANNY REAVIS PHONE: Business Home (704) 546-2607

ADDRESS 303 RAVEN ROAD, HARMONY NC 28634

LOCATION US 21 N, TR NC 901, TL SHEFFIELD ROAD, TL RAVEN ROAD, HOUSE AT END AT #303

SUBDIVISION BLOCK / SECTION LOT LOT AREA SITE CLASS. P-3 DESIGN FLOW 480 L.T.A.R. EXISTING

Septic Tank: EXISTING 1250 Gallons; STB Date
Pump Tank: Gallons; PT Date
Pump Make: Model Serial No.
Nitrification Field: No Fields 1 Square Feet 360 Linear Feet 120
No Lines ONE Trench Width 36" Max Trench Bottom Depth 36" Gravel Depth 18"

☐ New System ☑ Repair System Type: I (II) III. IV. V. VI
System Description:
Repair System Description: CONVENTIONAL GRAVITY
Maintenance Agreement Required ☐ Yes ☑ No


☑ House/Mod. Home No. Bedrooms 4
☐ Mobile Home No. Bathrooms 2
☐ Business No. Employees
☐ Other
☐ Slab ☐ Crawl Space ☐ Basement w/plumbing ☐ Basement wo/plumbing

Water Supply: ☑ Individual ☐ Public ☐ Community WELL

Comments:/Conditions: THIS PERMIT SERVES AS "NOTICE OF VIOLATION" SYSTEM TO BE REPAIRED BY JANUARY 20, 2002 @ INSTALL NEW SANITARY TEE IN SEPTIC TANK IF NECESSARY

Comments:/Conditions:

INITIAL SITE SKETCH

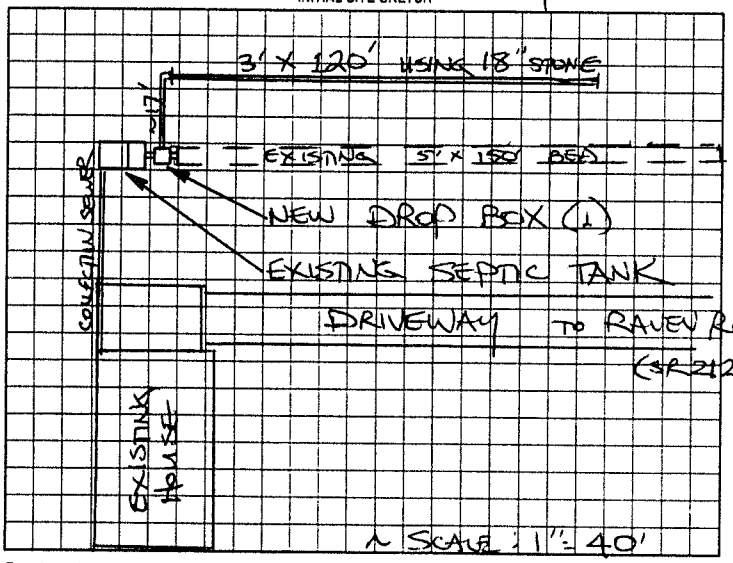

AS BUILT SKETCH

SYSTEM REPAIRED ACCORDING TO INITIAL SITE SKETCH

Permit can be suspended or revoked if any false information is supplied toward securing the permit/any unauthorized changes are made to the site/any unauthorized changes are made in the installation of the system. Improvement Permit with plat valid without expiration. Improvement Permit with site plan valid for sixty months. Authorization to Construct is valid for a period equal to that of Improvement Permit - not to exceed sixty months.

Signed: +Daniel A. Raben date 12-19-01 Installed by: SAMMY REAVIS

Improvement Permit by: STEVE HEDRICK date 12-19-01 Operation Permit by: STEVE HEDRICK date 12-31-01

Authorization to Construct by: STEVE HEDRICK date 12-19-01 Existing System Inspection by: date

HEALTH DEPT COPY WHITE OWNER COPY (FINAL) YELLOW OWNER COPY (INITIAL) PINK