46584

IREDELL COUNTY HEALTH DEPARTMENT

STATESVILLE 704-878-5305 MOORESVILLE 704-664-5281

IMPROVEMENT PERMIT / CERTIFICATE OF COMPLETION / OPERATION PERMIT / EXISTING SYSTEM INSPECTION

PROPERTY DESCRIPTION NO. 15967 DATE 9/9/93 TAX MAP NO. 17G-A-59

OWNER OR CONTRACTOR LARRY GALLIHER PHONE: Business Home

ADDRESS

LOCATION US 21 N, TR POWELL RD, TR HAMLET RD, 1ST LOT ON (L)

SUBDIVISION BLOCK / SECTION LOT LOT AREA SITE CLASS. PS L.T.A.R. 0.35 GPD/FT

Water Supply: ☑ Individual ☐ Community ☐ Public WELL

Septic Tank: 1000 Gallons; STB 358 Date 7/8/93

Pump Tank: Gallons; PT Date

Nitrification Field: No Fields 1 Square Feet 1035 Linear Feet 345

No Lines 3 Trench Width 36" Trench Depth <36" Gravel Depth 12"

☑ New System ☐ Repair System Type: (I) I, IV, V, VI

System Description: CONV. GRAVITY

Repair System Description: CONV. GRAVITY

Maintenance Agreement Required: ☐ Yes ☐ No

☐ House/Mod. Home No. Bedrooms 3 Garbage Disposal: ☐ Yes ~~☑ No~~

☐ Mobile Home No. Bathrooms 2½ Auto. Dishwasher: ~~☑ Yes~~ ☐ No


☐ Business No. Employees Auto. Washing Machine: ~~☑ Yes~~ ☐ No

☐ Other Other


☐ Slab ☐ Crawl Space ☑ Basement w/plumbing ☐ Basement wo/plumbing

Comments

INITIAL SITE SKETCH

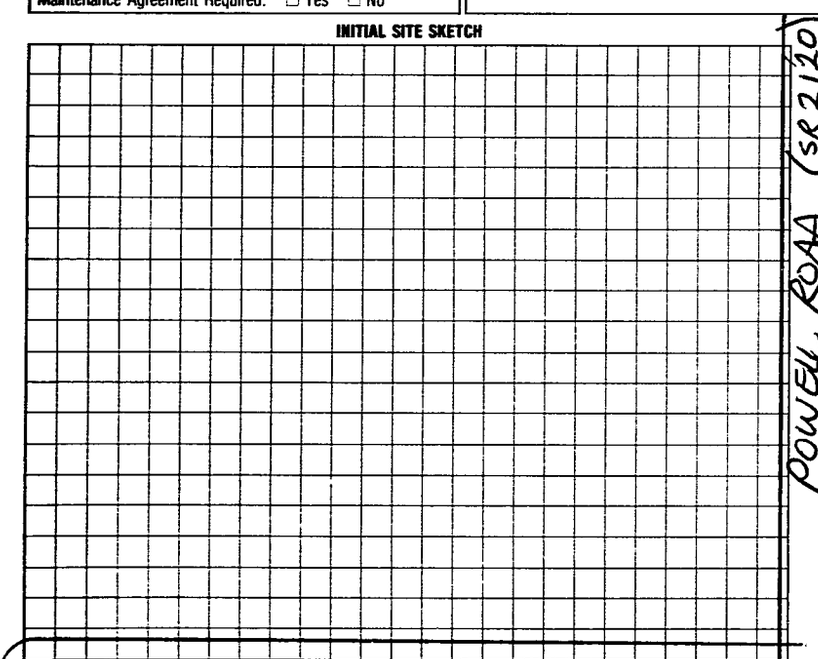

AS BUILT SKETCH

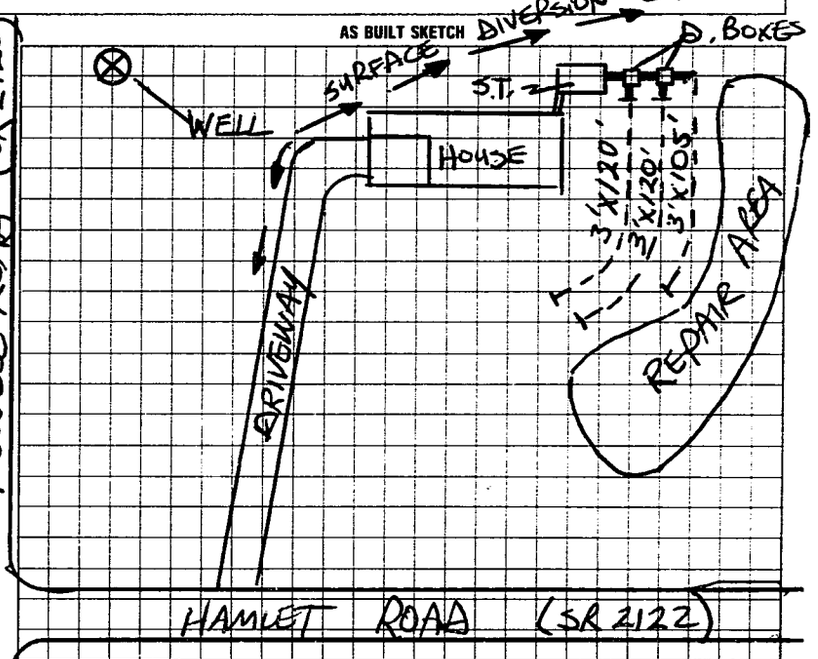

I understand that this permit can be suspended or revoked if any false information is supplied toward securing the permit, any unauthorized changes are made to the site/any unauthorized changes are made in the installation of the system. Improvement Permit is valid for 60 months from date of issuance.

Signed:

Improvement Permit by: STEVE HEDRICK date 3/12/93

Existing System Inspection by: date

Installed by: A-1 BACKHOE

Certificate of Completion by: STEVE HEDRICK date 9/9/93

Operation Permit by: date

HEALTH DEPT. COPY: WHITE INSPECTION COPY (FINAL): GREEN OWNER COPY (FINAL): YELLOW INSPECTION COPY (INITIAL): PINK OWNER COPY (INITIAL): GOLD