IREDELL COUNTY HEALTH DEPARTMENT

Statesville Office (704) 878-5305 Mooresville Office (704) 660-3625 PERMIT # 177316

IMPROVEMENT PERMIT / AUTHORIZATION TO CONSTRUCT / OPERATION PERMIT / EXISTING SYSTEM

PIN # 4881-95-6837

APPLICANT: LARRY D. HILTON APPLICANT ADDRESS: 223 HAMLET ROAD, HARMONY NC 28634

SITE ADDRESS: 223 HAMLET ROAD, HARMONY NC 28634 PHONE: 704-546-5463 ALT. PHONE: 704-902-2178

SITE DIRECTIONS: US 21 NORTH, TR POWELL BRIDGE RD, TR HAMLET RD, 2ND HOUSE ON LEFT AT #223

SUBDIVISION: N/A SECTION: N/A LOT # N/A LOT AREA: 17.95 ACRES DESIGN FLOW: 360 L.T.A.R.: 0.30 GPD/FT2

Septic Tank EXISTING (gal) STB Date

Pump Tank (gal) PT Date

Pump Make Model Serial #

Nitrification Fields 1 # Lines (5) FIVE Linear Ft: 300

Trench Width 36" Max. Trench Bottom Depth 36" Gravel Depth N/A

☐ New System ☑ Repair ☐ Expansion System Type: I II (III) IV V VI

System Description: EXISTING CONVENTIONAL

Repair System Description: 25% REDUCTION

Maintenance Agreement Required: ☐ YES ☑ NO


☑ GRAVITY ☐ PRESSURE

☑ Residence No. Bedrooms 3
☐ Business No. Persons
☐ Other No. Employees
☐ Slab ☐ Crawl Space
☑ Basement w/plumbing ☐ Basement w/o plumbing

Water Supply
☐ Private
☑ Public
☐ Community

Comments / Conditions: INSTALL 25% REDUCTION SYSTEM ON CONTOUR AS SHOWN, USING SERIAL DISTRIBUTION

INITIAL SITE SKETCH

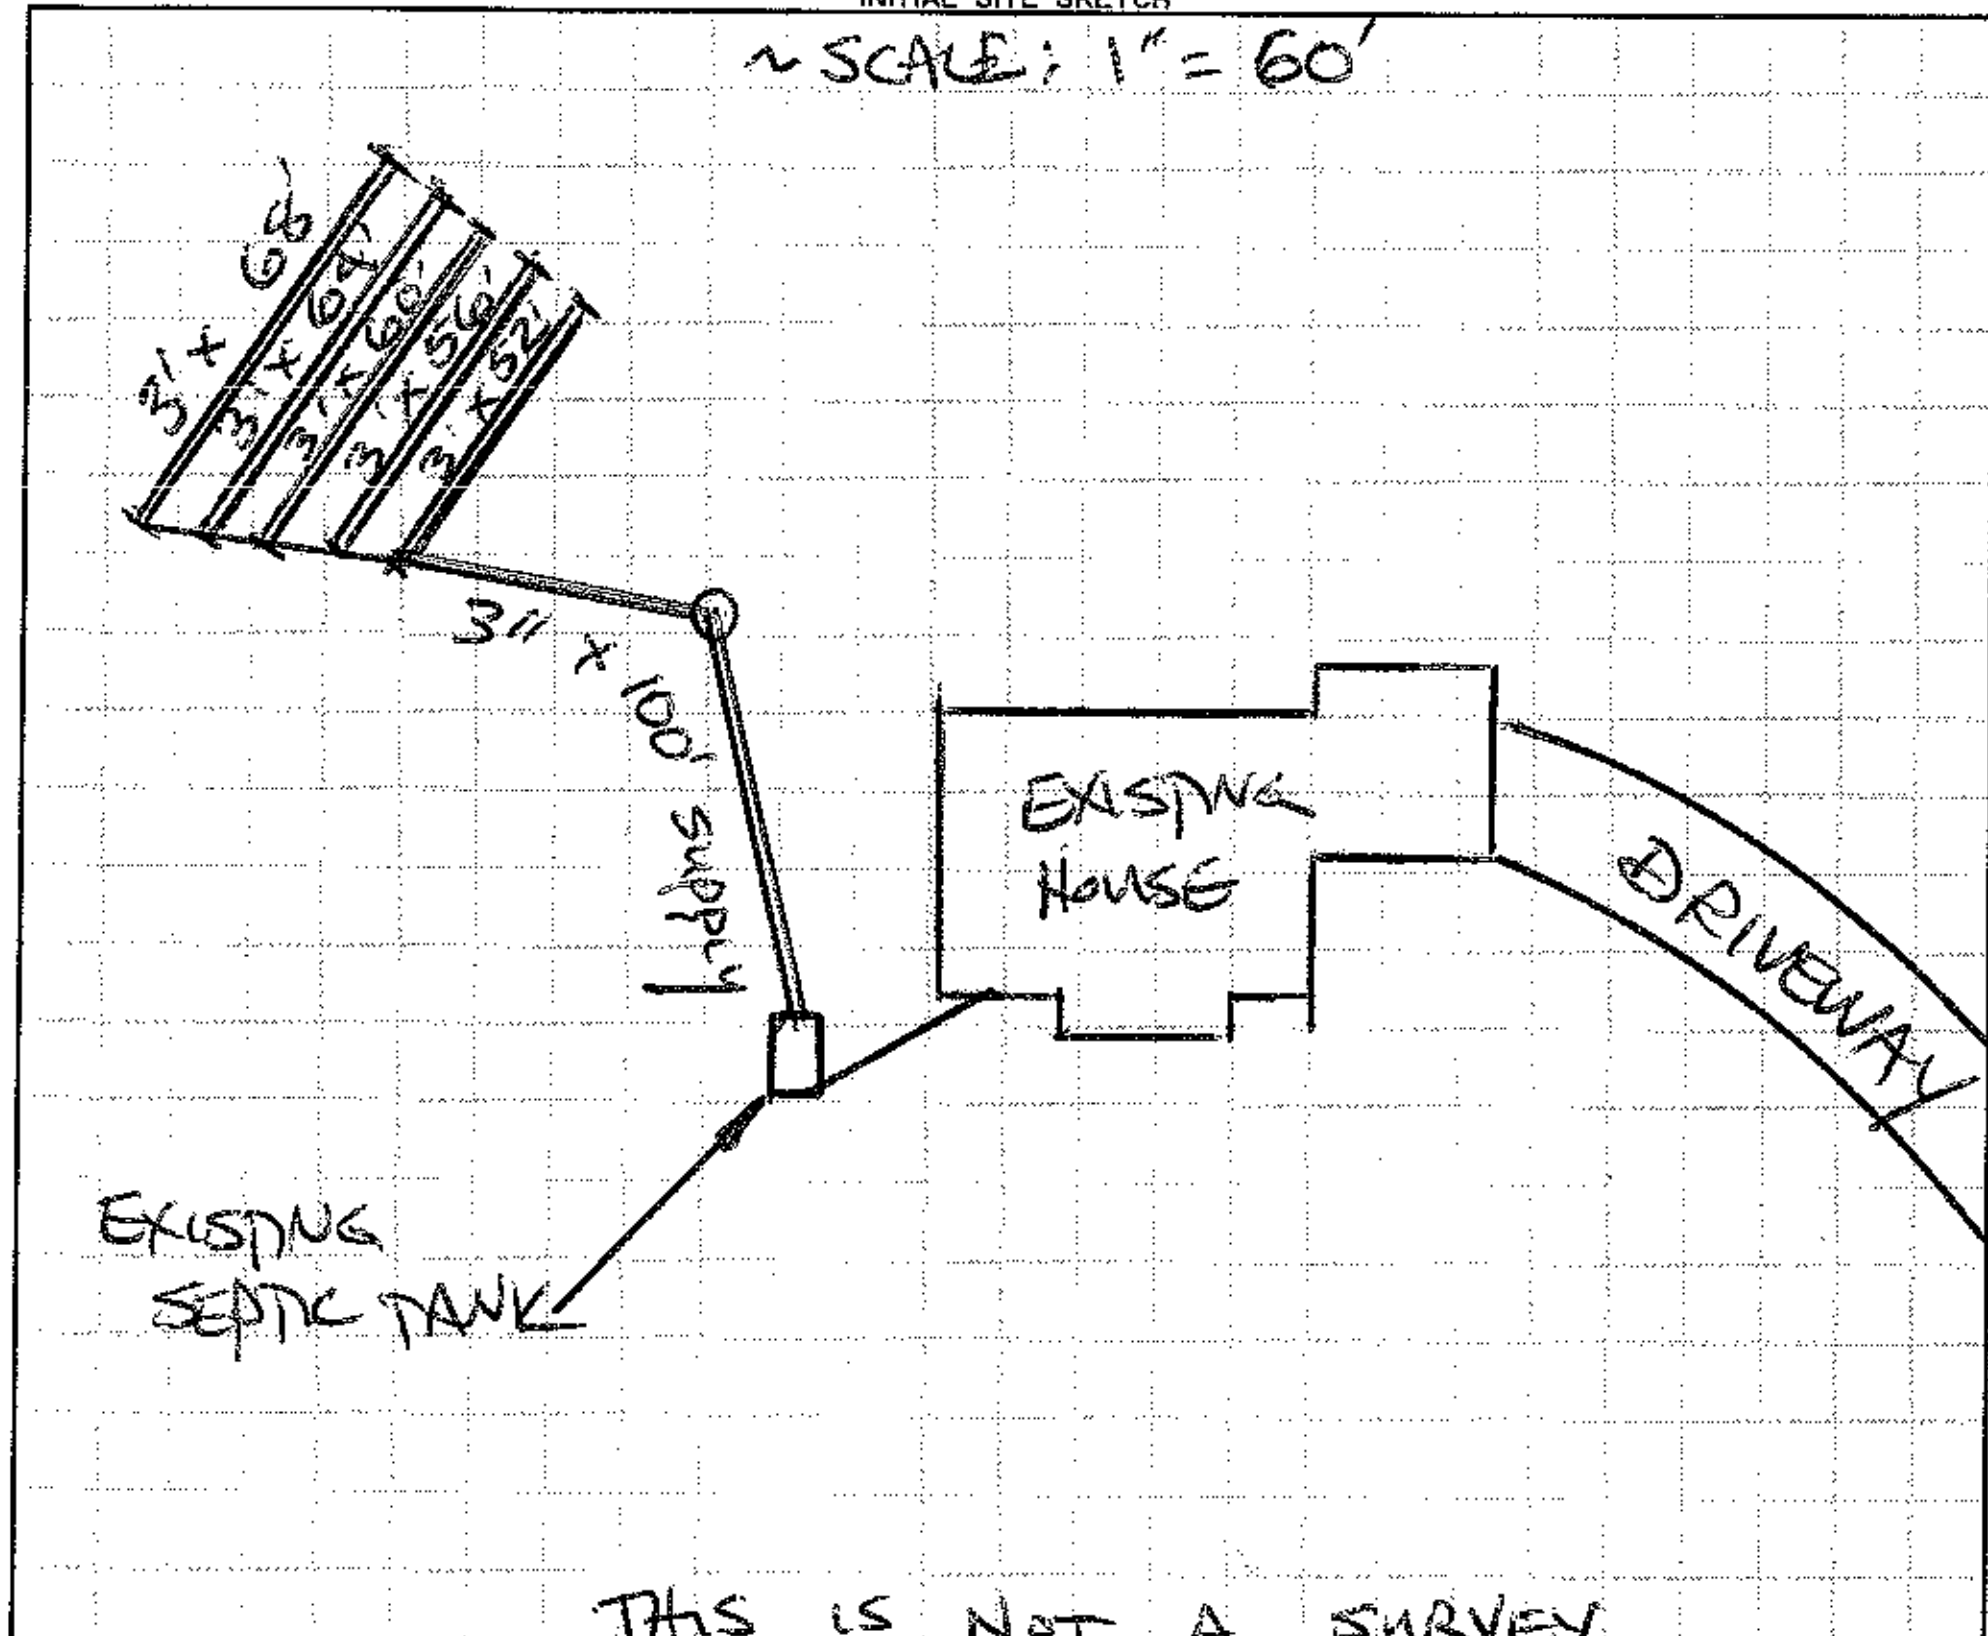

AS BUILT SKETCH

Permit can be suspended or revoked if any false information is supplied toward securing the permit / any unauthorized changes are made to the site / any unauthorized changes are made in the installation of the system. **CONTACT A LOCATOR SERVICE PRIOR TO ANY EXCAVATION**

☐ **IMPROVEMENT PERMIT *with plat*** *valid without expiration.* ☑ **IMPROVEMENT PERMIT *with site plan*** *valid for 60 mos.* ☑ **AUTHORIZATION TO CONSTRUCT** *valid for period equal to IMPROVEMENT PERMIT--not to exceed 60 mo.*

Owner / Applicant Signature: [signature] Date: 3-11-13 Installed by: Groundbreakers

IMPROVEMENT PERMIT by: R. STEVE HEDRICK Date: 3-6-13 OPERATION PERMIT by: [signature] Date: 4-5-13

AUTHORIZATION TO CONSTRUCT by: R. STEVE HEDRICK Date: 3-6-13 Existing System Inspected by: Date:

Health Dept. Copy - WHITE Applicant (Final Approval) - YELLOW Applicant (Conditional Approval) - PINK