IREDELL COUNTY HEALTH DEPARTMENT

STATESVILLE 704-878-5305 MOORESVILLE 704-664-5281

IMPROVEMENT PERMIT / AUTHORIZATION TO CONSTRUCT / OPERATION PERMIT / EXISTING SYSTEM INSPECTION

PERMIT# 190382 PIN# 4-3819-78342 42 DATE 2-5-07

OWNER OR APPLICANT Barry Gallehue PHONE: Business _____ Home 704-929-999

ADDRESS 109 Hamlet Rd. Harmony, NC 28634

LOCATION 21N to Powell Bridge, across 2nd Bridge, Mile on Right

SUBDIVISION _____ BLOCK / SECTION _____ LOT _____ LOT AREA _____ SITE CLASS. B5 DESIGN FLOW 360 L.T.A.R. .3

Septic Tank: 1000 Gallons: STB 740 Date 2-2-06
Pump Tank: _____ Gallons: PT _____ Date _____
Pump Make: _____ Model _____ Serial No. _____
Nitrification Field: No Fields ___ Square Feet 1200 Linear Feet 300
No Lines 4 Trench Width 36" Max Trench Bottom Depth 36" Gravel Depth NA ☐ Gravity ☐ Pressure

☐ New System ☐ Repair ☐ Expansion ☒ System Type: I II (III) IV V VI
System Description: EVI Strong
Repair System Description: _____
Maintenance Agreement Required: ☐ Yes ☐ No

☐ House/Mod. Home No. Bedrooms 3
☐ Mobile Home No. Persons ___
☐ Business No. Employees ___
☐ Other _____


Water Supply: ☑ Individual ☐ Public ☐ Community

☐ Slab ☐ Crawl Space ☐ Basement w/plumbing ☐ Basement wo/plumbing


Comments:/Conditions:

Comments:/Conditions: Yellow Surf-Site
NO Risers
NO Septic tank marker

INITIAL SITE SKETCH

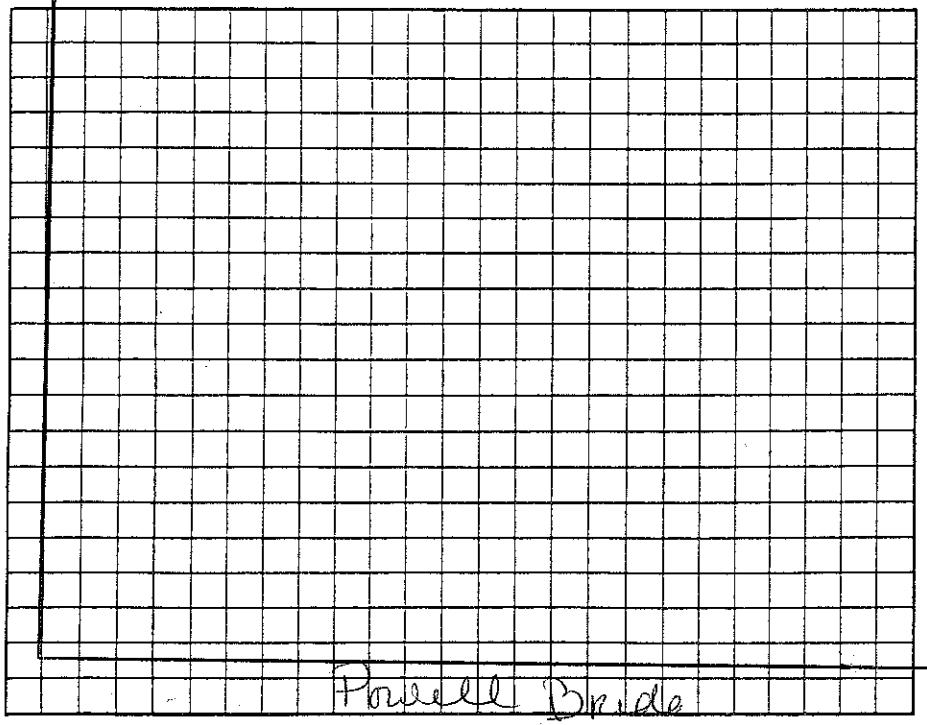

AS BUILT SKETCH

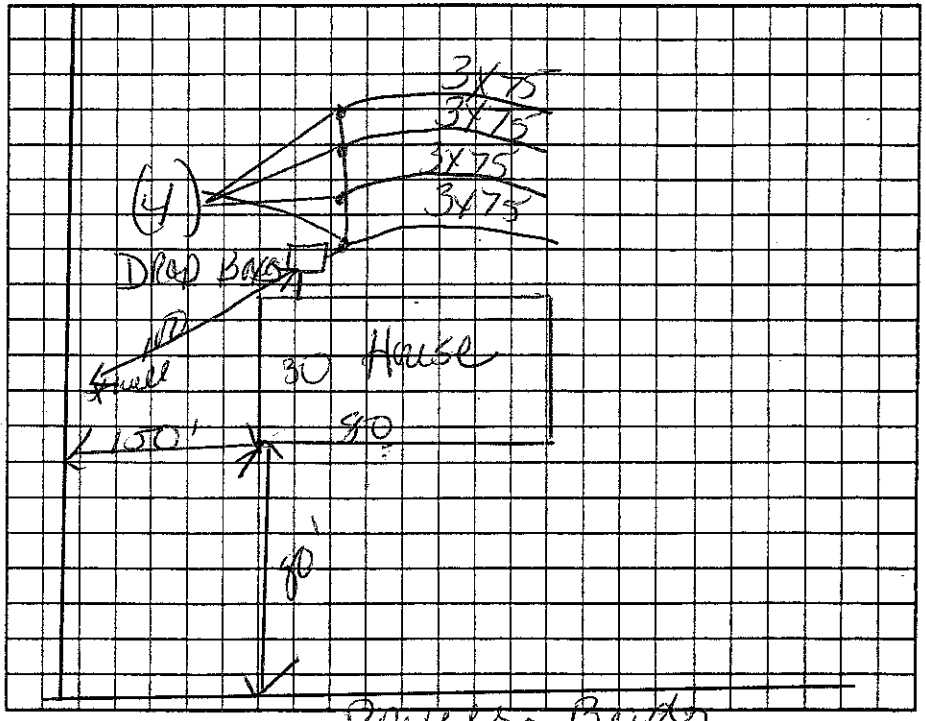

Permit can be suspended or revoked if any false information is supplied toward securing the permit/any unauthorized changes are made to the site/any unauthorized changes are made in the installation of the system. Improvement Permit with plat valid without expiration. ☐ Improvement Permit with site plan valid for sixty months ☐ Authorization to Construct is valid for a period equal to that of Improvement Permit – not to exceed sixty months.

Signed: Charles Gallehue date _____ Installed by: _____

Improvement Permit by: _____ date _____ Operation Permit by: _____ date _____

Authorization to Construct by: _____ date _____ Existing System Inspection by: Kelly J. Cook date 2-5-07

HEALTH DEPT. COPY: WHITE OWNER COPY (FINAL): YELLOW OWNER COPY (INITIAL): PINK