# IREDELL COUNTY HEALTH DEPARTMENT

STATESVILLE 704-878-5305 MOORESVILLE 704-664-5281

## IMPROVEMENT PERMIT / AUTHORIZATION TO CONSTRUCT / OPERATION PERMIT / EXISTING SYSTEM INSPECTION

PERMIT# 102088 PIN# 4882-05-1261 DATE 9-17-01

OWNER OR CONTRACTOR GINA JOHNSON PHONE: Business Home (704) 546-7453

ADDRESS 231 E. HOUSTONVILLE RD, HARMONY, NC 28634

LOCATION US 21 N, TR E. HOUSTONVILLE RD, TL AT BOX #231, BACK OFF ROAD ~1000 FEET

SUBDIVISION BLOCK / SECTION LOT LOT AREA 1.790 ACRES SITE CLASS FS5 DESIGN FLOW 240 L.T.A.R. 0.30 GAD/FT²

Septic Tank: 1000 Gallons: STB 760 Date 5-26-01
Pump Tank: Gallons: PT Date
Pump Make: Model Serial No
Nitrification Field: No Fields 1 Square Feet 810 Linear Feet 270
No Lines THREE Trench Width 36" Max Trench Bottom Depth 36" Gravel Depth 12"

☑ New System ☐ Repair System Type: I (II) III. IV. V. VI
System Description: CONVENTIONAL GRAVITY
Repair System Description: CONV. GRAVITY
Maintenance Agreement Required: ☐ Yes ☑ No
☐ Slab ☑ Crawl Space ☐ Basement w/plumbing ☐ Basement wo/plumbing


☐ House/Mod. Home No. Bedrooms 2
☑ Mobile Home No. Bathrooms 2
☐ Business No. Employees
☐ Other

Water Supply: ☑ Individual ☐ Public ☐ Community
WELL

Comments/Conditions:

Comments/Conditions: SEPTIC TANK WITH MARKER INSTALLED USING "ZABEL" FILTER

INITIAL SITE SKETCH SCALE: 1" = 40'

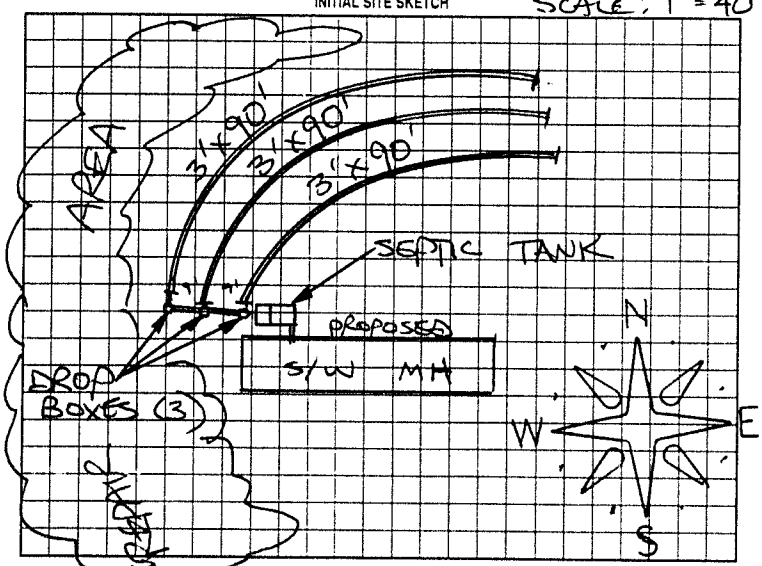


AS BUILT SKETCH

SYSTEM INSTALLED ACCORDING TO INITIAL SITE SKETCH

Permit can be suspended or revoked if any false information is supplied toward securing the permit/any unauthorized changes are made to the site/any unauthorized changes are made in the installation of the system. Improvement Permit with plat valid without expiration. Improvement Permit with site plan valid for sixty months. Authorization to Construct is valid for a period equal to that of Improvement Permit -- not to exceed sixty months.

Signed: Kay L Johnson date 9-17-01 Installed by: BRENT GAUTHER

Improvement Permit by: STEVE HEDRICK date 9-17-01 Operation Permit by: STEVE HEDRICK date 11-08-01

Authorization to Construct by: STEVE HEDRICK date 9-17-01 Existing System Inspection by: date

HEALTH DEPT. COPY WHITE OWNER COPY (FINAL) YELLOW OWNER COPY (INITIAL) PINK