IREDELL COUNTY HEALTH DEPARTMENT

THIS PERMIT VOIDS PREVIOUS ISSUED 1-5-00

STATESVILLE 704-878-5305 MOORESVILLE 704-664-5281

IMPROVEMENT PERMIT / AUTHORIZATION TO CONSTRUCT / OPERATION PERMIT / EXISTING SYSTEM INSPECTION

PERMIT# 86916 PIN# 4882 05 3635 DATE 11/9/00

OWNER OR CONTRACTOR Tammy Johnson PHONE: Business 546-7706 Home

ADDRESS 119 Grose St. Harmony NC 28634

LOCATION 21 N, R E. Hoston ville RD. On Lt behind Johnson Prof Farm

SUBDIVISION BLOCK / SECTION LOT LOT AREA 1.67 AC SITE CLASS PS DESIGN FLOW 360 L.T.A.R. 0.5

Septic Tank: 1000 Gallons; STB 794 Date 7-14-00
Pump Tank: Gallons; PT Date
Pump Make: Model Serial No
Nitrification Field: No Fields 1 Square Feet 1200 Linear Feet 400
No Lines 5 Trench Width 36" Max Trench Bottom Depth 36" Gravel Depth 12"

[X] New System [ ] Repair System Type: [I] II, III, IV, V, VI
System Description: Grav'ty Conv.
Repair System Description: Gravity 25% Red
Maintenance Agreement Required: [ ] Yes [ ] No
[ ] Slab [X] Crawl Space [ ] Basement w/plumbing [ ] Basement wo/plumbing


[ ] House/Mod. Home No. Bedrooms 3
[X] Mobile Home No. Bathrooms 2
[ ] Business No. Employees
[ ] Other

Water Supply: [X] Individual [ ] Public [ ] Community


Comments/Conditions: Keep sys tem 100' from well

Comments/Conditions: SEPTIC TANK WITH MARKER INSTALLED USING "ZABEL" FILTER

INITIAL SITE SKETCH

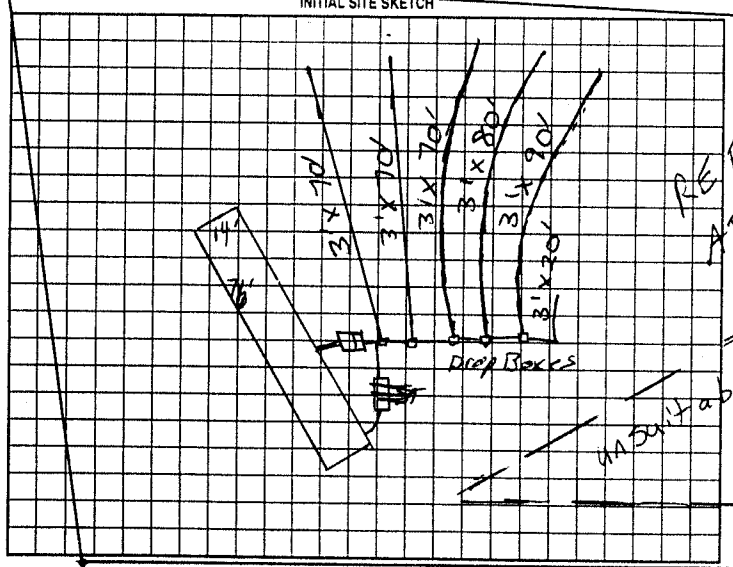

AS BUILT SKETCH

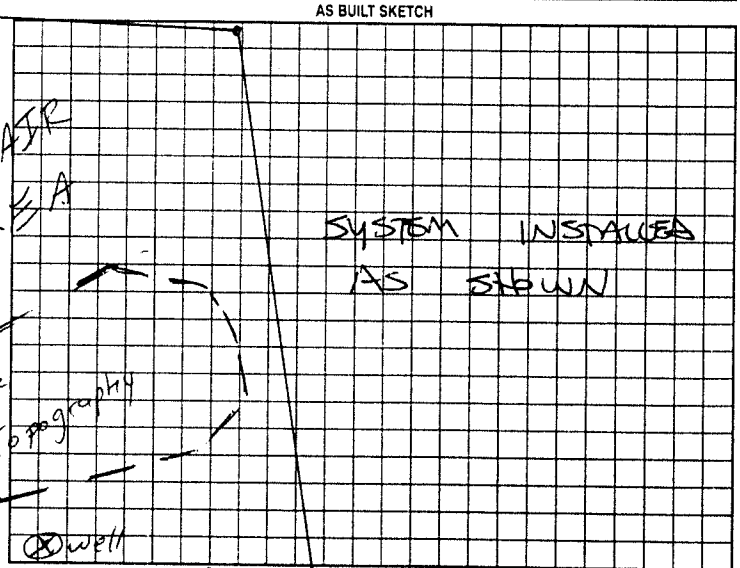

Permit can be suspended or revoked if any false information is supplied toward securing the permit/any unauthorized changes are made to the site/any unauthorized changes are made in the installation of the system. Improvement Permit with plat valid without expiration. Improvement Permit with site plan valid for sixty months. Authorization to Construct is valid for a period equal to that of Improvement Permit – not to exceed sixty months.

Signed: Johnathan Brannon date 11-13-00 Installed by: ANDY DANIELS

Improvement Permit by: RSZ date 11/9/00 Operation Permit by: STEVE HEDRICK date 11-13-00

Authorization to Construct by: RSZ date 11/9/00 Existing System Inspection by: date

HEALTH DEPT. COPY: WHITE OWNER COPY (FINAL): YELLOW OWNER COPY (INITIAL): PINK