# IREDELL COUNTY HEALTH DEPARTMENT

STATESVILLE 704-878-5305 MOORESVILLE 704-664-5281

## IMPROVEMENT PERMIT / CERTIFICATE OF COMPLETION / OPERATION PERMIT / EXISTING SYSTEM INSPECTION

PROPERTY DESCRIPTION NO. 19197 DATE 7/8/94 TAX MAP NO. 176-A-22 Watershed: ☐ Yes ☑ No

OWNER OR CONTRACTOR GEORGE K. COCKERHAM PHONE: Business Home 596-5856

ADDRESS 596 KENNESAW RD, HARMONY, NC 28634

LOCATION US 21N, TR POWELL RD, TL KENNESAW RD, ~ 1 MILE ON (L) PAST MAYBERRY RD.

SUBDIVISION BLOCK / SECTION LOT LOT AREA 5.95 AC SITE CLASS. PS DESIGN FLOW 240 L.T.A.R. EXISTING

Septic Tank: EXISTING Gallons; STB Date

Pump Tank: Gallons; PT Date

Pump Make: Model Serial No.

Nitrification Field: No. Lines 4 Square Feet I Linear Feet EXISTING

Trench Width Max. Trench Bottom Depth Gravel Depth

☑ New System ☐ Repair System Type: I II III IV V VI

System Description: CONV. GRAVITY

Repair System Description:

Maintenance Agreement Required: ☐ Yes ☑ No

☐ House/Mod. Home No. Bedrooms 1

☐ Mobile Home No. Bathrooms 1

☐ Business No. Employees

☑ Other TEMP. CAMPER


☐ Slab ☑ Crawl Space ☐ Basement w/plumbing ☐ Basement wo/plumbing

Water Supply: ☑ Individual ☐ Community ☐ Public


Comments:

Comments:

**INITIAL SITE SKETCH**

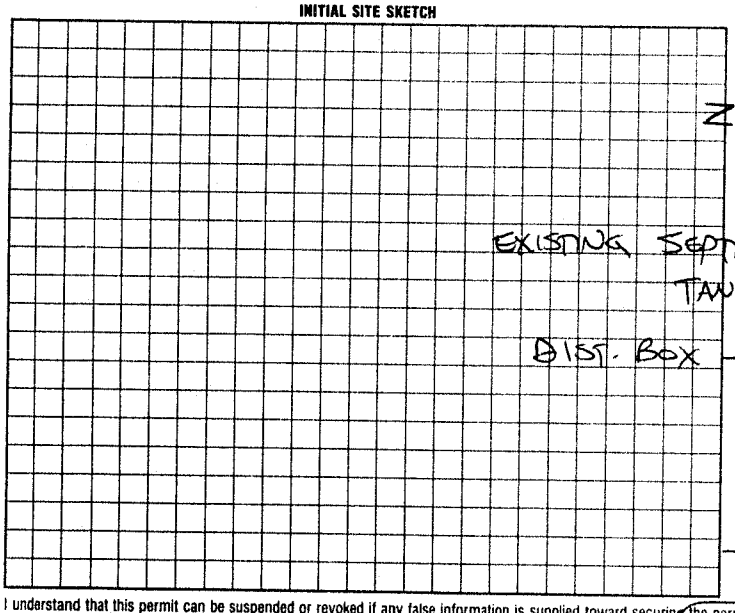


**AS BUILT SKETCH**

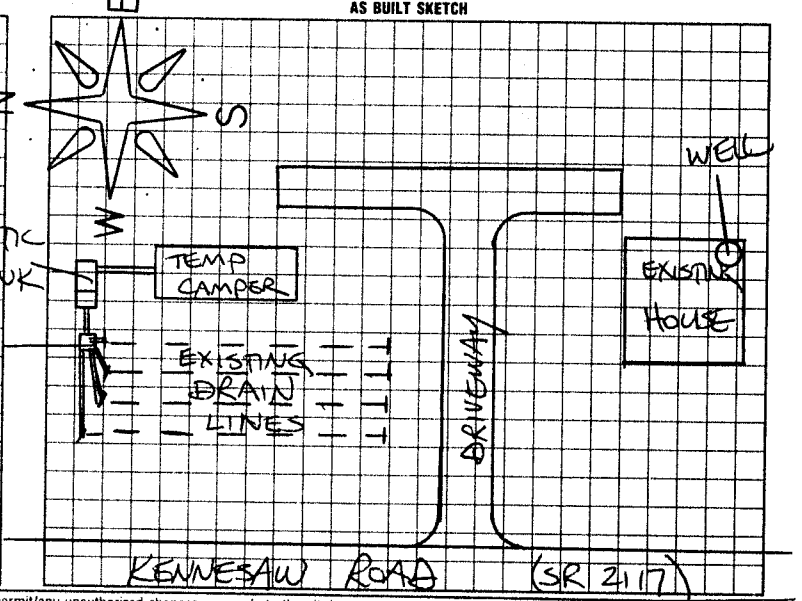


I understand that this permit can be suspended or revoked if any false information is supplied toward securing the permit/any unauthorized changes are made to the site/any unauthorized changes are made in the installation of the system. Improvement Permit is valid for 60 months from date of issuance.

Signed:

Improvement Permit by: date

Existing System Inspection by: STEVE HEDRICK date 7/8/94

Installed by:

Certificate of Completion by: date

Operation Permit by: date

HEALTH DEPT. COPY: WHITE INSPECTION COPY (FINAL): GREEN OWNER COPY (FINAL): YELLOW INSPECTION COPY (INITIAL): PINK OWNER COPY (INITIAL): GOLD