IREDELL COUNTY HEALTH DEPARTMENT

THIS PERMIT VOIDS PREVIOUS ISSUED 5-20-97

STATESVILLE 704-878-5305 MOORESVILLE 704-664-5281

IMPROVEMENT PERMIT / AUTHORIZATION TO CONSTRUCT / OPERATION PERMIT / EXISTING SYSTEM INSPECTION

PERMIT# 066418 PIN# 4882 21 4000 DATE 1-3-00

OWNER OR CONTRACTOR HAROLD STANLEY PHONE: Business Home 539-5013

ADDRESS 248 JERICHO ROAD, HARMONY, NC 28634

LOCATION US 21N, TR E. HOUSTONVILLE RD, TR KENNESAW ROAD, 0.5 MILE ON LEFT

SUBDIVISION BLOCK / SECTION LOT LOT AREA 3.0 ACRES SITE CLASS PS DESIGN FLOW 240 L.T.A.R. 0.35 GPD/FT

Septic Tank: 1000 Gallons: STB 319 Date 1-9-99
Pump Tank: Gallons: PT Date
Pump Make: Model Serial No.
Nitrification Field: No Fields 1 Square Feet 690 Linear Feet 230
No Lines TWO Trench Width 36" Max Trench Bottom Depth 36" Gravel Depth 12"

☑ New System ☐ Repair System Type: I (II) III. IV. V. VI
System Description: CONVENTIONAL GRAVITY
Repair System Description: CONVENTIONAL GRAVITY
Maintenance Agreement Required: ☐ Yes ☑ No
☐ Slab ☑ Crawl Space ☐ Basement w/plumbing ☐ Basement wo/plumbing


☑ House/Mod. Home No. Bedrooms 2
☑ Mobile Home No. Bathrooms 1
☐ Business No. Employees
☐ Other

Water Supply: ☑ Individual ☐ Public ☐ Community
WELL


Comments:/Conditions:

Comments:/Conditions: SEPTIC TANK WITH MARKER INSTALLED USING "ZABEL" FILTER

INITIAL SITE SKETCH

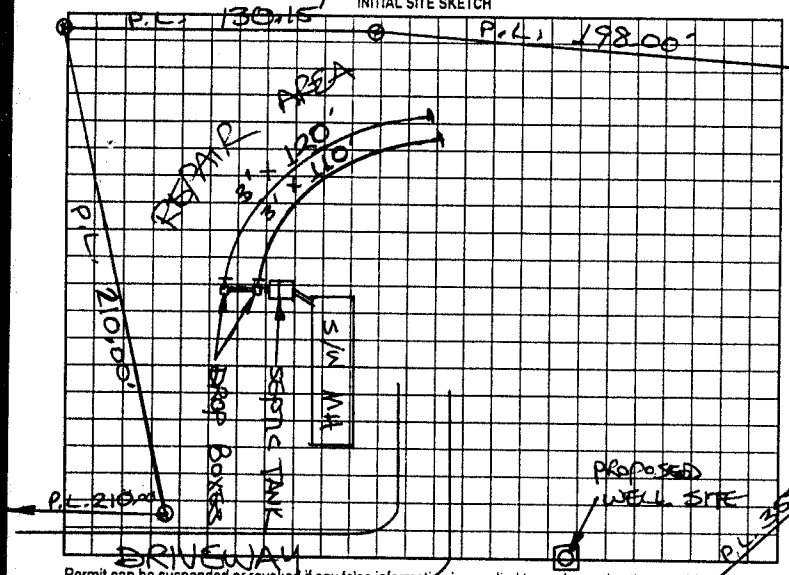

AS BUILT SKETCH

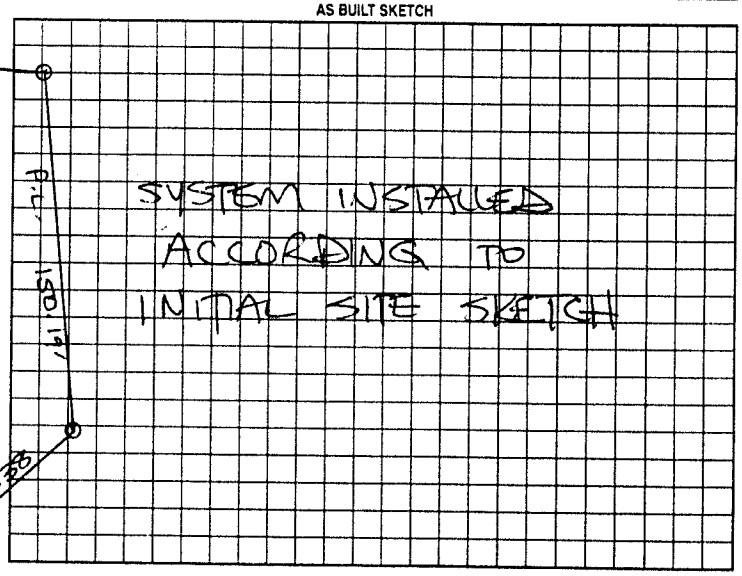

Permit can be suspended or revoked if any false information is supplied toward securing the permit/any unauthorized changes are made to the site/any unauthorized changes are made in the installation of the system. Improvement Permit with plat valid without expiration. Improvement Permit with site plan valid for sixty months. Authorization to Construct is valid for a period equal to that of Improvement Permit – not to exceed sixty months.

Signed: + Harold E. Stanley date 1-3-00 Installed by: DAVID UMGARGER

Improvement Permit by: STEVE HEDRICK date 1-3-00 Operation Permit by: STEVE HEDRICK date 2-28-00

Authorization to Construct by: STEVE HEDRICK date 1-3-00 Existing System Inspection by: date

HEALTH DEPT. COPY WHITE OWNER COPY (FINAL) YELLOW OWNER COPY (INITIAL) PINK