IREDELL COUNTY HEALTH DEPARTMENT

STATESVILLE 704-878-5305 MOORESVILLE 704-664-5281

IMPROVEMENT PERMIT / AUTHORIZATION TO CONSTRUCT / OPERATION PERMIT / EXISTING SYSTEM INSPECTION

PERMIT# 130040 PIN# 4882358088 DATE 5-8-08

OWNER OR APPLICANT Justin Henderson PHONE: Business 336-468-4665 Home 336-244-2227

ADDRESS 5924 Johnson RD Statesville

LOCATION 21N to Houstonville 1/4 mile mile left Hunting Creek bridge

SUBDIVISION _____ BLOCK / SECTION _____ LOT _____ LOT AREA 1.61 SITE CLASS P3 DESIGN FLOW 360 L.T.A.R. .25

Septic Tank: 1000 Gallons; STB 630 Date 9-15-03

Pump Tank: _____ Gallons; PT _____ Date _____

Pump Make: _____ Model _____ Serial No. _____

Nitrification Field: No Fields ___ Square Feet 1440 Linear Feet 480

No Lines 5 Trench Width 36" Max Trench Bottom Depth 30" Gravel Depth 12

☑ New System ☐ Repair ☐ Expansion System Type: Conventional

System Description: Gravel - Gravel II

Repair System Description: Gravel - Gravel II

Maintenance Agreement Required: ☐ Yes ☑ No

☑ Gravity ☐ Pressure

☐ House/Mod. Home No. Bedrooms 3

☐ Mobile Home No. Persons ___

☐ Business No. Employees ___

☐ Other ___


Water Supply: ☑ Individual ☐ Public ☐ Community

☐ Slab ☐ Crawl Space ☑ Basement w/plumbing ☐ Basement wo/plumbing

Comments:/Conditions:

well area

INITIAL SITE SKETCH

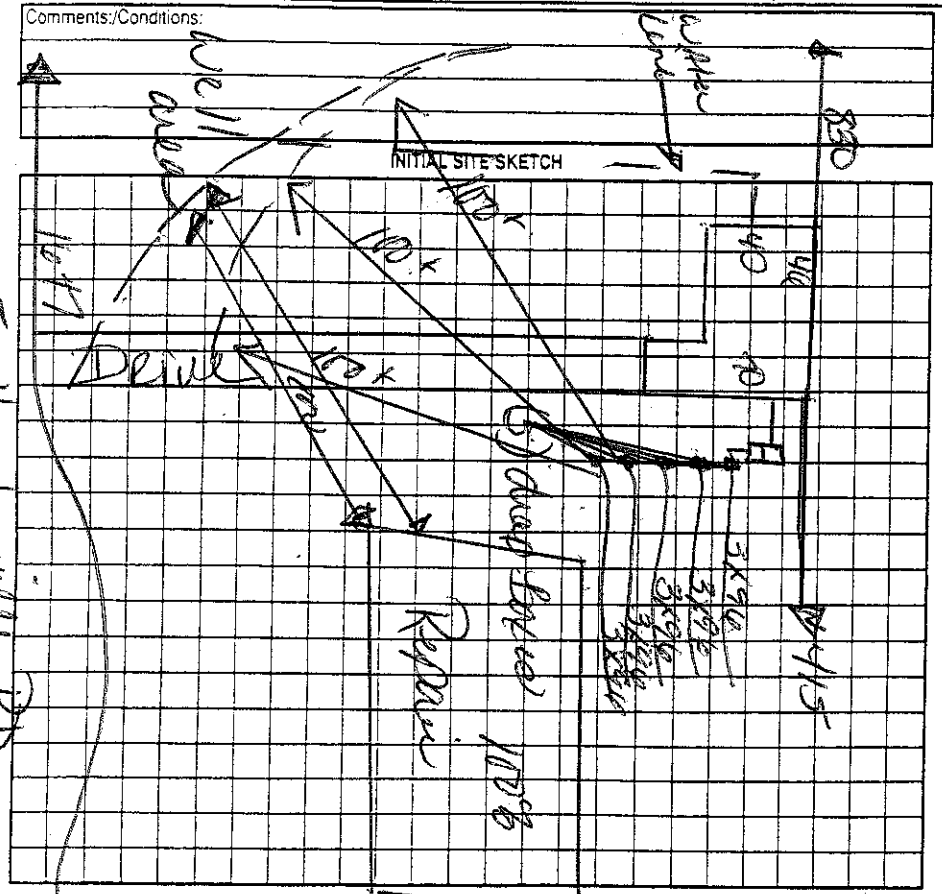

Comments:/Conditions:

Install on Contour
Maintain all setbacks

AS BUILT SKETCH

Maintain 100' Away from well area - and Repair

30" Trench

INSTALLED WITH POLYLOK FILTER

REFER TO *AS BUILT SKETCH*

Permit can be suspended or revoked if any false information is supplied toward securing the permit/any unauthorized changes are made to the site/any unauthorized changes are made in the installation of the system. Improvement Permit with plat valid without expiration ☐ Improvement Permit with site plan valid for sixty months ☑ Authorization to Construct is valid for a period equal to that of Improvement Permit – not to exceed sixty months.

Signed: Justin Henderson date _____

Improvement Permit by: Greg Cook date 5-8-08

Authorization to Construct by: Greg Cook date 5-8-08

Installed by: Tommy Nixon

Operation Permit by: Kyle Baker date 11-12-08

Existing System Inspection by: _____ date _____

HEALTH DEPT. COPY: WHITE OWNER COPY (FINAL): YELLOW OWNER COPY (INITIAL): PINK

IREDELL COUNTY HEALTH DEPARTMENT

STATESVILLE 704-878-5305 MOORESVILLE 704-664-5281

IMPROVEMENT PERMIT / AUTHORIZATION TO CONSTRUCT / OPERATION PERMIT / EXISTING SYSTEM INSPECTION

PERMIT # 150040 PIN # 4882358088 DATE 11-12-08

OWNER or APPLICANT Justin Henderson PHONE: Business 336-468-4665 Home: 336-244-2227

OWNER or APPLICANT ADDRESS 5924 Johnson Rd, Hamptonville, NC 27020

LOCATION / DIRECTIONS

SUBDIVISION BLOCK / SECTION LOT # LOT AREA 12.98 ACRE DESIGN FLOW 360gpd. L.T.A.R. .25

Septic Tank 1060 Gallons: STB 620 Date 9-15-08

Pump Tank Gallons: P T Date

Pump Make Model Serial #

Nitrification Field No Fields 1 No Lines 3 Linear Feet 500

Trench Width 36" Max. Trench Bottom Depth 30" Gravel Depth

☒ New System ☐ Repair ☐ Expansion System Type I (II) III IV V VI

System Description: gravel - gravity

Repair System Description: gravel-gravity

Maintenance Agreement Required ☐ YES ☒ NO

☒ GRAVITY ☐ PRESSURE

☒ Residence No. Bedrooms 3

☐ Business No. Persons

☐ Other No. Employees

☐ Slab ☐ Crawl Space


☒ Basement w/plumbing ☐ Basement w/o plumbing

Water Supply: ☒ Private ☐ Public ☐ Community


Comments / Conditions

Comments / Conditions

INITIAL SITE SKETCH

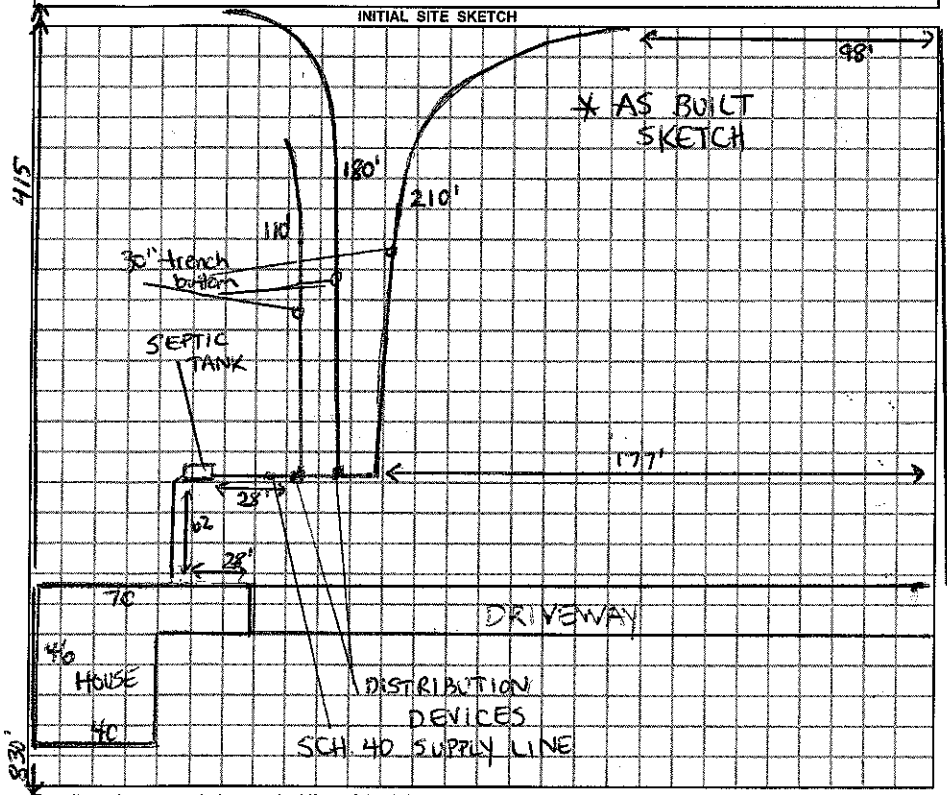

AS BUILT SKETCH

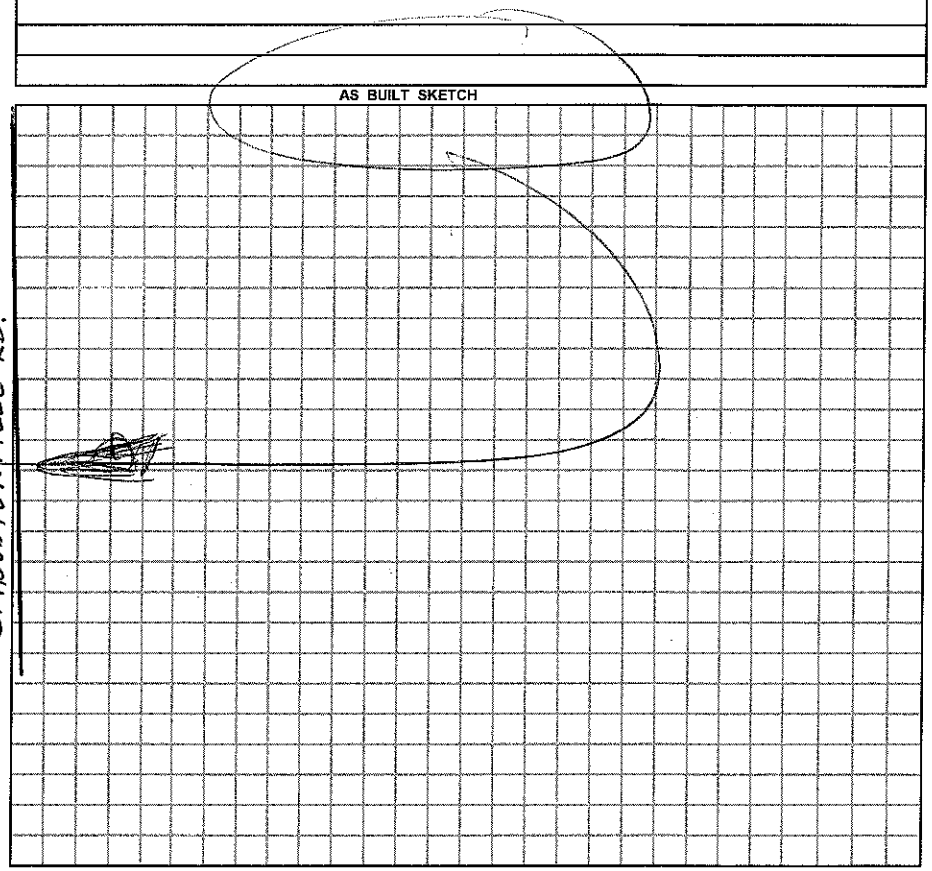

Permit can be suspended or revoked if any false information is supplied toward securing the permit / any unauthorized changes are made to the site / any unauthorized changes are made in the installation of the system.

☐ *IMPROVEMENT PERMIT w / plat valid without expiration.* ☒ *IMPROVEMENT PERMIT w / site plan valid for 60 mos.* ☐ *AUTHORIZATION TO CONSTRUCT valid for period equal to IMPROVEMENT PERMIT-not to exceed 60 mo.*

Owner / Applicant Signature: Date

Improvement Permit by: Date

Authorzation to Construct by: Date

YOU SHOULD CONTACT A LOCATOR SERVICE PRIOR TO ANY EXCAVATION.

Installed by: Tommy Hilpen

Operation Permit by: Date: 11-12-08

Existing System Inspected by: Date:

WHITE COPY Environmental Health YELLOW COPY (Final) Owner / Applicant PINK COPY (Initial) Owner / Applicant