IREDELL COUNTY HEALTH DEPARTMENT

STATESVILLE 704-878-5305 MOORESVILLE 704-664-5281

IMPROVEMENT PERMIT / AUTHORIZATION TO CONSTRUCT / OPERATION PERMIT / EXISTING SYSTEM INSPECTION

PERMIT # 150040 PIN # 4882358088 DATE 11-12-08

OWNER or APPLICANT Justin Henderson PHONE: Business 336-468-4665 Home: 336-244-2227

OWNER or APPLICANT ADDRESS 5924 Johnson Rd, Hamptonville, NC 27020

LOCATION / DIRECTIONS

SUBDIVISION BLOCK / SECTION LOT # LOT AREA 12.98 ACRS. DESIGN FLOW 360gpd. L.T.A.R. .25

Septic Tank 1060 Gallons: STB 620 Date 9-15-08

Pump Tank Gallons: P T Date

Pump Make Model Serial #

Nitrification Field No Fields 1 No Lines 3 Linear Feet 500

Trench Width 36" Max. Trench Bottom Depth 30" Gravel Depth

☑ New System ☐ Repair ☐ Expansion System Type I (II) III IV V VI

System Description: gravel-gravity

Repair System Description: gravel-gravity

Maintenance Agreement Required ☐ YES ☒ NO

☒ GRAVITY ☐ PRESSURE

☒ Residence No. Bedrooms 3

☐ Business No. Persons

☐ Other No. Employees

☐ Slab ☐ Crawl Space


☒ Basement w/plumbing ☐ Basement w/o plumbing

Water Supply: ☒ Private ☐ Public ☐ Community


Comments / Conditions

Comments / Conditions

INITIAL SITE SKETCH

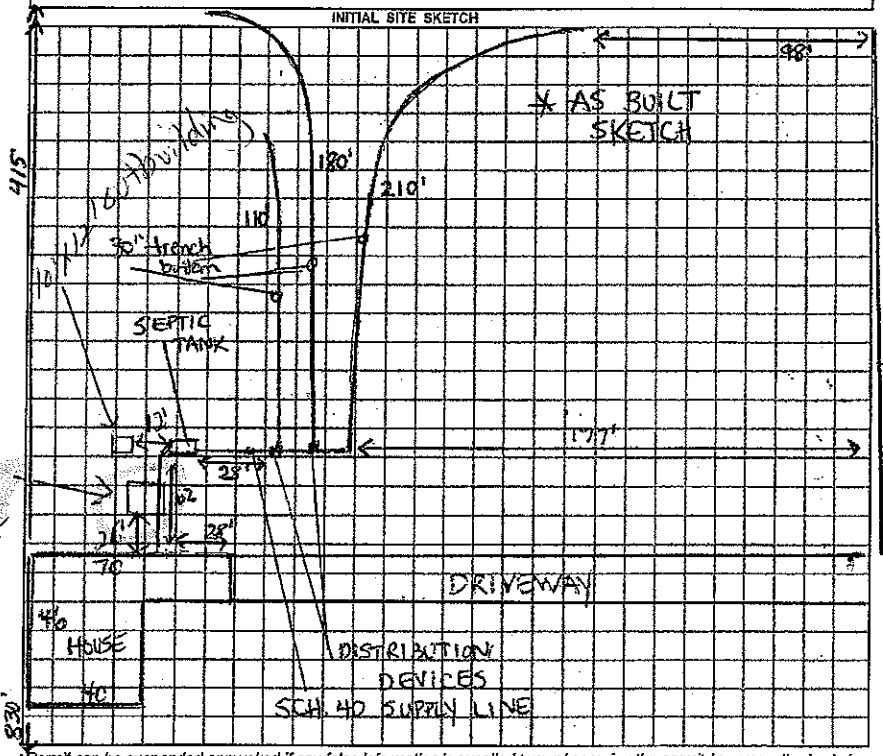

AS BUILT SKETCH

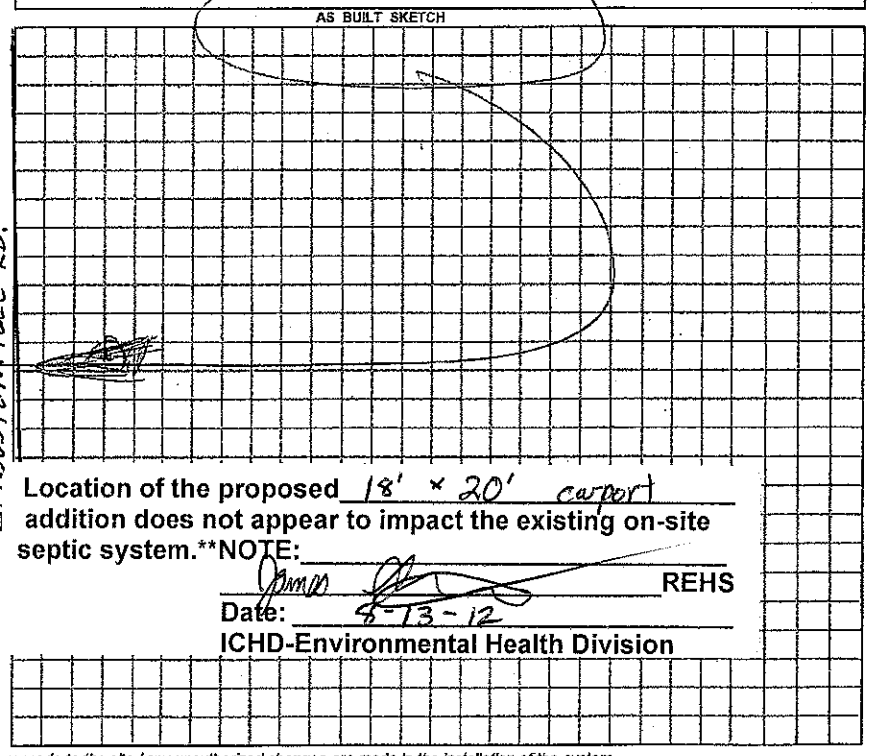

Location of the proposed 18' x 20' carport addition does not appear to impact the existing on-site septic system.**NOTE:

REHS

Date: 8-13-12

ICHD-Environmental Health Division

Permit can be suspended or revoked if any false information is supplied toward securing the permit / any unauthorized changes are made to the site / any unauthorized changes are made in the installation of the system.

☐ *IMPROVEMENT PERMIT w / plat valid without expiration.* ☒ *IMPROVEMENT PERMIT w / site plan valid for 60 mos.* ☐ *AUTHORIZATION TO CONSTRUCT valid for period equal to IMPROVEMENT PERMIT-not to exceed 60 mo.*

Owner / Applicant Signature: Date

Improvement Permit by: Date

Authorzation to Construct by: Date

YOU SHOULD CONTACT A LOCATOR SERVICE PRIOR TO ANY EXCAVATION.

Installed by: Tommy Griffin

Operation Permit by: Date: 11-12-08

Existing System Inspected by: Date:

WHITE COPY Environmental Health YELLOW COPY (Final) Owner / Applicant PINK COPY (Initial) Owner / Applicant