CI

IREDELL COUNTY HEALTH DEPARTMENT

STATESVILLE 704-878-5305 MOORESVILLE 704-664-5281

IMPROVEMENT PERMIT / AUTHORIZATION TO CONSTRUCT / OPERATION PERMIT / EXISTING SYSTEM INSPECTION

PERMIT# 105925 PIN# 4882-52-3895 DATE 5-8-02

OWNER OR CONTRACTOR BRENDA HARRIS PHONE: Business Home 704-539-4636

ADDRESS 671 JERICHO ROAD, HARMONY NC 28634

LOCATION US 21 N, TR E. HOUSTONVILLE RD, TR ABBEYDALE ROAD, 0.3 MILE ON LEFT

SUBDIVISION BLOCK / SECTION LOT LOT AREA 1.22 ACRES SITE CLASS. PS DESIGN FLOW 360 L.T.A.R. 0.25 GPD/FT²

Septic Tank: 1000 Gallons; STB 760 Date 4-8-03
Pump Tank: Gallons; PT Date
Pump Make: Model Serial No.
Nitrification Field: No Fields 1 Square Feet EQ TO 1440 Linear Feet 360
No Lines SIX Trench Width 36" Max Trench Bottom Depth 36" Gravel Depth N/A

☑ New System ☐ Repair System Type: I, II, III, IV, V, VI
System Description: 25% REDUCTION, GRAVITY
Repair System Description: 25% REDUCTION, PUMP
Maintenance Agreement Required: ☐ Yes ☑ No


☐ House/Mod. Home No. Bedrooms 3
☑ Mobile Home No. Bathrooms 2
☐ Business No. Employees
☐ Other
☐ Slab ☑ Crawl Space ☐ Basement w/plumbing ☐ Basement wo/plumbing

Water Supply: ☑ Individual ☐ Public ☐ Community
WELL NEXT DOOR


Comments:/Conditions: ① KEEP SYSTEM MAXIMUM FEASIBLE DISTANCE FROM WELL (55') ② INSTALL 25% REDUCTION SYSTEM IN SIX EQUAL LENGTH LINES AS SHOWN ③ USE ONE FLOW DIVIDER TEE AS SHOWN.

Comments:/Conditions: LABEL FILTER & MARKER INSTALLED AS DRAWN & FLAGGED USED AN ADJUSTABLE FD TEE. HOUSE/SW IS 25' OFF P/L INSTEAD OF 15' AS DRAWN. SYSTEM DID NOT CHANGE. OWNER SHOWED INSTALLER & ME P/L.

INITIAL SITE SKETCH

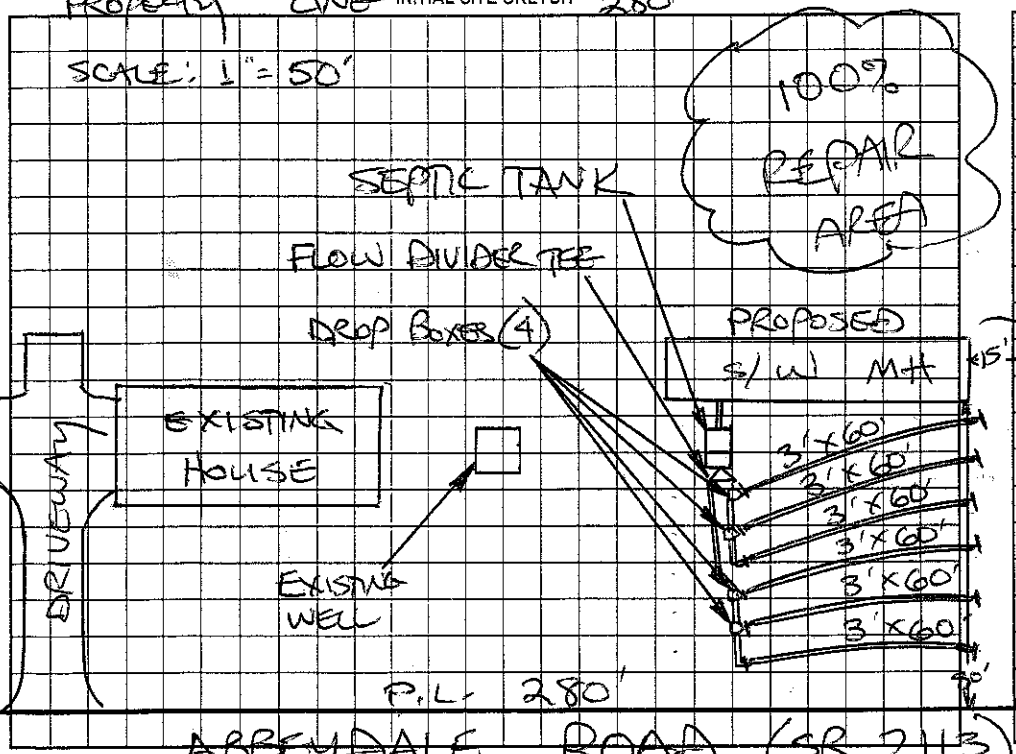

AS BUILT SKETCH

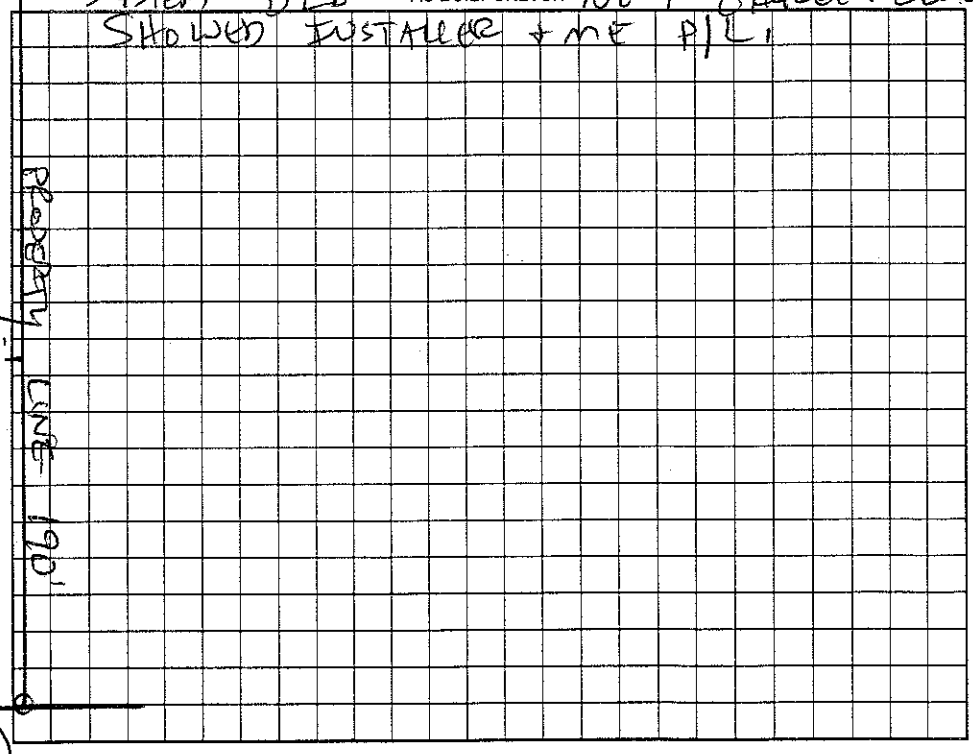

Permit can be suspended or revoked if any false information is supplied toward securing the permit/any unauthorized changes are made to the site/any unauthorized changes are made in the installation of the system. Improvement Permit with plat valid without expiration. Improvement Permit with site plan valid for sixty months. Authorization to Construct is valid for a period equal to that of Improvement Permit – not to exceed sixty months.

Signed: Brenda Harris date 5-8-02 Installed by: RANDY MILLER & SONS

Improvement Permit by: STEVE HEDRICK date 5-8-02 Operation Permit by: date 8-15-03

Authorization to Construct by: STEVE HEDRICK date 5-8-02 Existing System Inspection by: date

HEALTH DEPT. COPY: WHITE OWNER COPY (FINAL): YELLOW OWNER COPY (INITIAL): PINK