IREDELL COUNTY HEALTH DEPARTMENT

STATESVILLE 704-878-5305 MOORESVILLE 704-664-5281

IMPROVEMENT PERMIT / AUTHORIZATION TO CONSTRUCT / OPERATION PERMIT / EXISTING SYSTEM INSPECTION

PERMIT# [redacted]100480 PIN# 4882 54 6550 DATE 5-3-01

OWNER OR CONTRACTOR TIM GUNTER PHONE: Business Home (704) 546-7119

ADDRESS 173 REAVIS RD HARMONY NC 28634

LOCATION US 21 N, TR E, HOUSTONVILLE RD, TR REAVIS RD, 1ST DRIVE ON LEFT AT #173

SUBDIVISION BLOCK / SECTION LOT LOT AREA 2.4 ACRES SITE CLASS. PS DESIGN FLOW 360 L.T.A.R. 0.25 GPD/FT²

Septic Tank: 1000 Gallons; STB Date

Pump Tank: Gallons; PT Date

Pump Make: Model Serial No.

Nitrification Field: No Fields 1 Square Feet 1440 Linear Feet 480

No Lines SIX Trench Width 36" Max Trench Bottom Depth 36" Gravel Depth 12"

☒ New System ☐ Repair System Type: (I) II. IV. V. VI

System Description: CONVENTIONAL GRAVITY

Repair System Description: 25% REDUCTION, GW

Maintenance Agreement Required: ☐ Yes ☒ No

☐ Slab ☒ Crawl Space ☐ Basement w/plumbing ☐ Basement wo/plumbing

☐ House/Mod. Home No. Bedrooms 3

☐ Mobile Home No. Bathrooms 2

☐ Business No. Employees


☐ Other

Water Supply: ☒ Individual ☐ Public ☐ Community WELL


Comments/Conditions:

Comments/Conditions ① KEEP MOBILE HOME MINIMUM 5 FEET FROM SYSTEM ② SYSTEM SIZED FOR 3 BEDROOMS ONLY

INITIAL SITE SKETCH

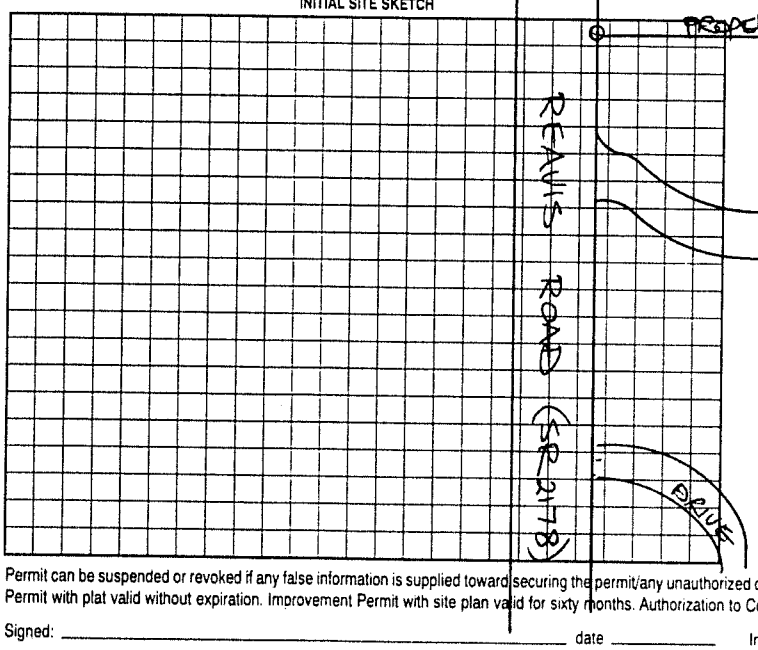

AS BUILT SKETCH

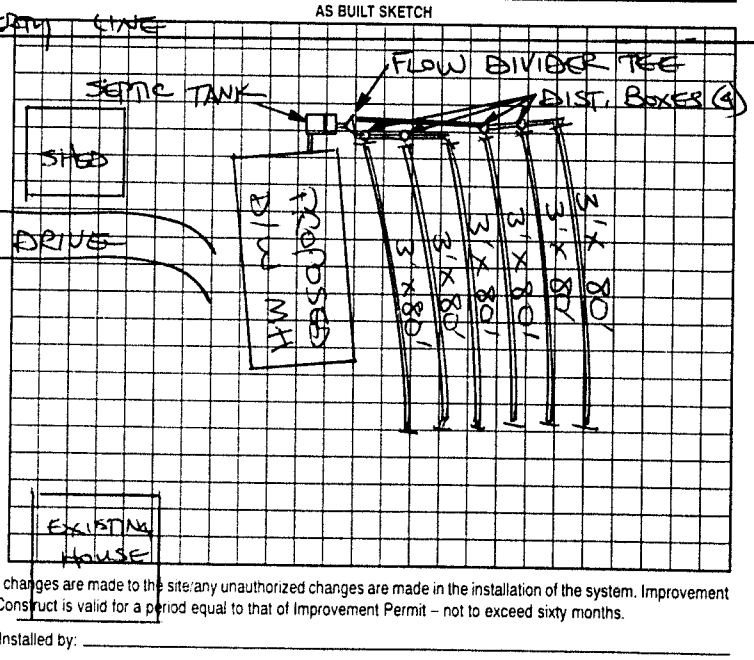

Permit can be suspended or revoked if any false information is supplied toward securing the permit/any unauthorized changes are made to the site/any unauthorized changes are made in the installation of the system. Improvement Permit with plat valid without expiration. Improvement Permit with site plan valid for sixty months. Authorization to Construct is valid for a period equal to that of Improvement Permit – not to exceed sixty months.

Signed: date

Improvement Permit by: date

Authorization to Construct by: date

Installed by:

Operation Permit by: date

Existing System Inspection by: STEVE HENDRICK date 5-3-01

HEALTH DEPT COPY: WHITE OWNER COPY (FINAL): YELLOW OWNER COPY (INITIAL): PINK