IREDELL COUNTY HEALTH DEPARTMENT

STATESVILLE 704-878-5305 MOORESVILLE 704-664-5281

IMPROVEMENT PERMIT / AUTHORIZATION TO CONSTRUCT / OPERATION PERMIT / EXISTING SYSTEM INSPECTION

PERMIT# 1999163 PIN# 4882545351 DATE 9-4-07

OWNER OR APPLICANT Kimberly Gunter PHONE: Business _____ Home 704-546-3437

ADDRESS 123 Regis RD Harmony NC 28634

LOCATION 21W (TO) Houstonville (TO) Regis RD 1st Drive on left

SUBDIVISION _____ BLOCK / SECTION _____ LOT _____ LOT AREA .76 SITE CLASS. FS DESIGN FLOW 360 L.T.A.R. 1.25

Septic Tank 1000 Gallons; STB Existing Date Existing
Pump Tank: _____ Gallons; PT _____ Date _____
Pump Make: _____ Model _____ Serial No. _____
Nitrification Field: No Fields ____ Square Feet 1440 Linear Feet 480 ?
No Lines (4-5) Trench Width 36" Max Trench Bottom Depth 32" Gravel Depth _____

☐ New System ☐ Repair ☐ Expansion System Type: I II III IV V VI
System Description: Existing
Repair System Description: _____
Maintenance Agreement Required: ☐ Yes ☐ No

☐ House/Mod. Home No. Bedrooms 3
☑ Mobile Home No. Persons ____
☐ Business No. Employees ____
☐ Other _____

Water Supply: ☐ Individual ☐ Public ☑ Community


☐ Slab ☑ Crawl Space ☐ Basement w/plumbing ☐ Basement wo/plumbing

Comments:/Conditions:


(6) Supply 30" deep

Comments:/Conditions:

INITIAL SITE SKETCH

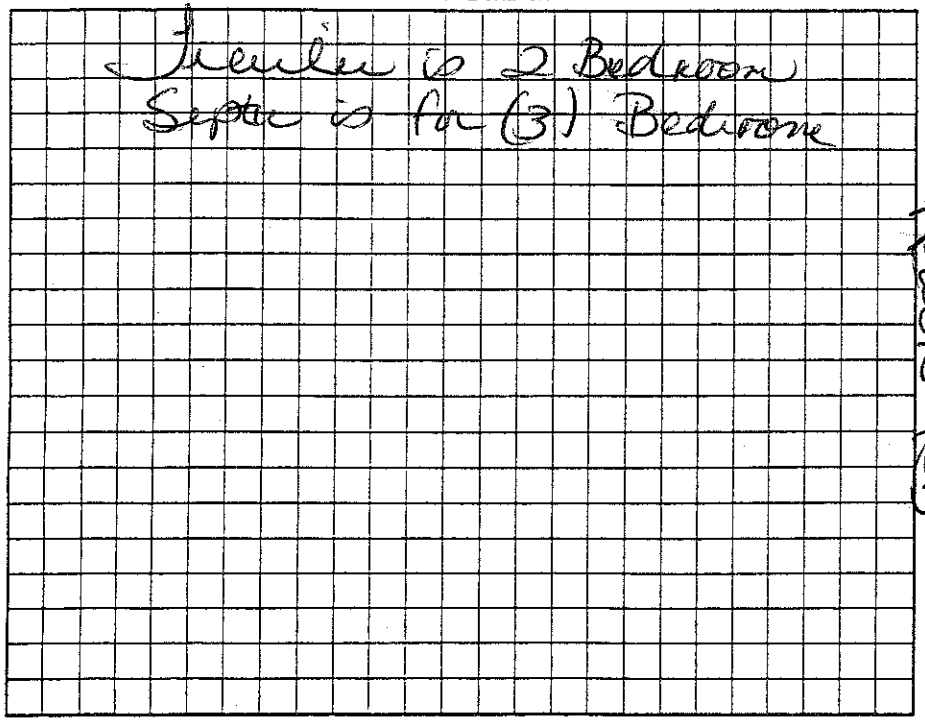

AS BUILT SKETCH

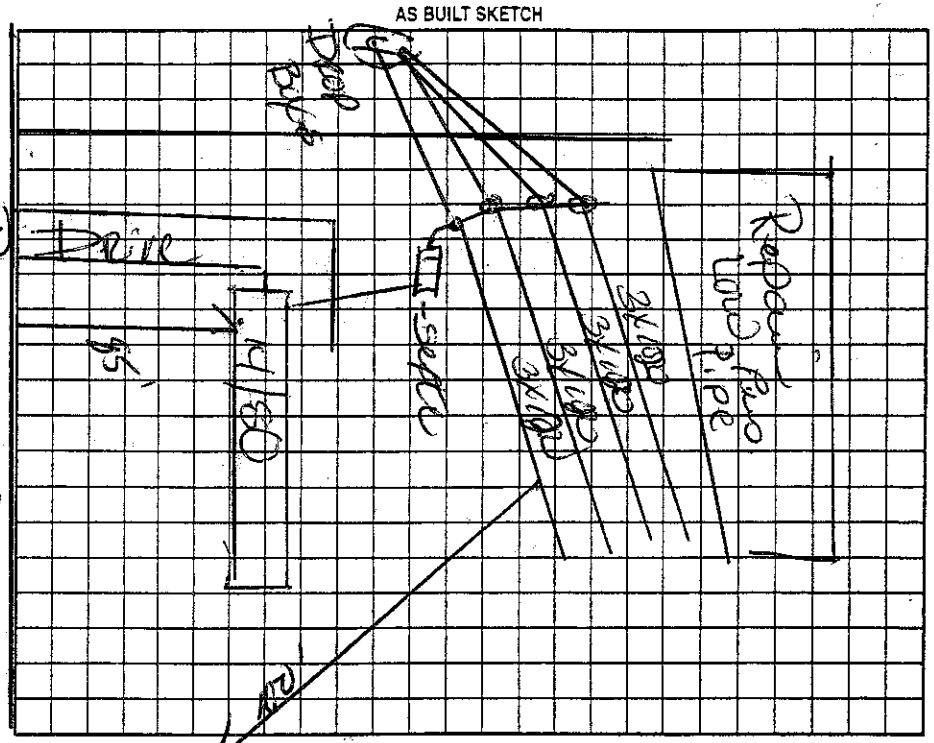

Permit can be suspended or revoked if any false information is supplied toward securing the permit/any unauthorized changes are made to the site/any unauthorized changes are made in the installation of the system. Improvement Permit with plat valid without expiration. ☐ Improvement Permit with site plan valid for sixty months ☐ Authorization to Construct is valid for a period equal to that of Improvement Permit – not to exceed sixty months.

Signed: _____ date _____ Installed by: _____

Improvement Permit by: _____ date _____ Operation Permit by: _____ date _____

Authorization to Construct by: _____ date _____ Existing System Inspection by: [signature] date 9-4-07

HEALTH DEPT. COPY: WHITE OWNER COPY (FINAL): YELLOW OWNER COPY (INITIAL): PINK