IREDELL COUNTY HEALTH DEPARTMENT

THIS PERMIT VOIDS PREVIOUS ISSUED 2-10-99

STATESVILLE 704-878-5305 (EH) MOORESVILLE 704-664-5281

IMPROVEMENT PERMIT / AUTHORIZATION TO CONSTRUCT / OPERATION PERMIT / EXISTING SYSTEM INSPECTION

PERMIT# 104417 PIN# 4882-54-6550.B DATE 2-07-02

OWNER OR CONTRACTOR STEVEN GUNTER PHONE: Business Home 704-546-2556

ADDRESS 2328 SANDY SPRINGS RD HARMONY NC 28634

LOCATION US 21 N, TR E. HOUSTONVILLE RD, TR REAVIS ROAD, 0.3 MILE ON LEFT

SUBDIVISION BLOCK / SECTION LOT LOT AREA 0.8312 ACRE SITE CLASS PS DESIGN FLOW 360 L.T.A.R. 0.25 GPD/FT

Septic Tank: 1000 Gallons: STB 1017 Date 10-3-01

Pump Tank: Gallons: PT Date

Pump Make: Model Serial No.

Nitrification Field: No Fields 1 Square Feet 600 TO 1440 Linear Feet 360

No Lines FOUR Trench Width 36" Max Trench Bottom Depth (24") Gravel Depth N/A

☑ New System ☐ Repair System Type: I, II, (III), IV, V, VI

System Description: 25% REDUCTION GRAVITY

Repair System Description: LOW PRESSURE PIPE

Maintenance Agreement Required: ☐ Yes ☑ No

☐ House/Mod. Home ☑ Mobile Home ☐ Business ☐ Other

No. Bedrooms 3 No. Bathrooms 2 No. Employees


☐ Slab ☑ Crawl Space ☐ Basement w/plumbing ☐ Basement wo/plumbing

Water Supply: ☑ Individual ☐ Public ☐ Community WELL


Comments/Conditions: ① KEEP SYSTEM MINIMUM 100 FEET FROM WELL ② INSTALL 25% REDUCTION SYSTEM AS FLAGGED ON SITE NO DEEPER THAN 24"

Comments/Conditions: SEPTIC TANK WITH MARKER INSTALLED USING "POLYLOK" FILTER

INITIAL SITE SKETCH

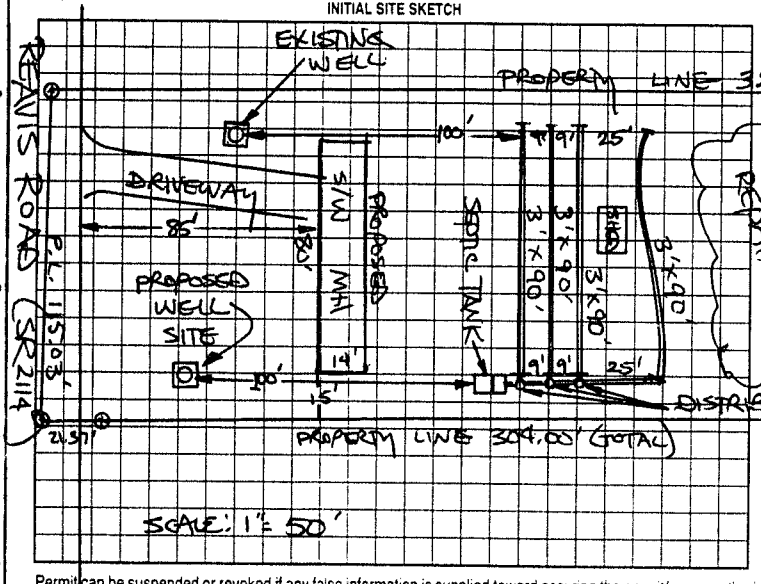

AS BUILT SKETCH

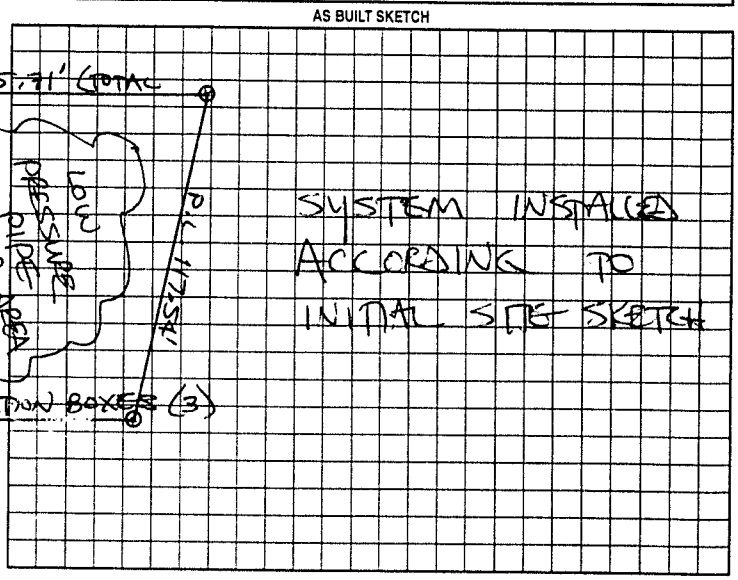

Permit can be suspended or revoked if any false information is supplied toward securing the permit/any unauthorized changes are made to the site/any unauthorized changes are made in the installation of the system. Improvement Permit with plat valid without expiration. Improvement Permit with site plan valid for sixty months. Authorization to Construct is valid for a period equal to that of Improvement Permit – not to exceed sixty months.

Signed: Steve Gunter date 2-07-02 Installed by: MITCHELL GRADING

Improvement Permit by: STEVE HENDRICK date 2-07-02 Operation Permit by: STEVE HENDRICK date 2-22-02

Authorization to Construct by: STEVE HENDRICK date 2-07-02 Existing System Inspection by: date

HEALTH DEPT. COPY: WHITE OWNER COPY (FINAL): YELLOW OWNER COPY (INITIAL): PINK