IREDELL COUNTY HEALTH DEPARTMENT - *ENVIRONMENTAL HEALTH* ☒ STATESVILLE OFFICE 704-878-5305 ☐ MOORESVILLE OFFICE 704-664-5281

IMPROVEMENT PERMIT / AUTHORIZATION TO CONSTRUCT / OPERATION PERMIT / EXISTING SYSTEM INSPECTION

PERMIT # 169606 PIN # 4882-79-9915 DATE 1-20-12

OWNER Richard / Kristin Renegar APPLICANT: Amrich Home Plus PHONE: Home/Cell # 828-779-2505 Business #

SITE ADDRESS 795 Houstonville Rd E. OWNER / APPLICANT ADDRESS same

SITE DIRECTIONS 77 N; exit 65, turn (R), (L) on Eagle Mills, (R) Houstonville; 795 E. Houstonville on (L)

SUBDIVISION n/a BLOCK / SECTION n/a LOT # LOT AREA 48.27 DESIGN FLOW 360 L.T.A.R. .3

Septic Tank 1000 Gallons: STB 1012 Date 10/21/11 ☒ New System ☐ Repair ☐ Expansion System Type I II (III) IV V VI

Pump Tank Gallons: P T Date System Description: 25% Reduction Gravity

Pump Make Model Serial # Repair System Description: 25% Reduction Gravity

No. Nitrification Fields: 1 No. Lines 3 Linear Feet 300 Maintenance Agreement Required ☐ YES ☐ NO

Trench Width 36" Max. Trench Bottom Depth 36" Gravel Depth n/a ☒ GRAVITY ☐ PRESSURE

☒ Residence No. Bedrooms 3 Water Supply

☐ Business No. Persons ☒ Private

☐ Other No. Employees ☐ Public

☐ Slab ☐ Crawl Space ☐ Community


☒ Basement w/plumbing ☐ Basement w/o plumbing

Comments / Conditions


(3) 3' x 100' lines
(3) drop boxes

POLYLOK FILTER
TP-STB-1012
43' SEWERLINE
WELL IS 100' FROM ST

INITIAL SITE SKETCH

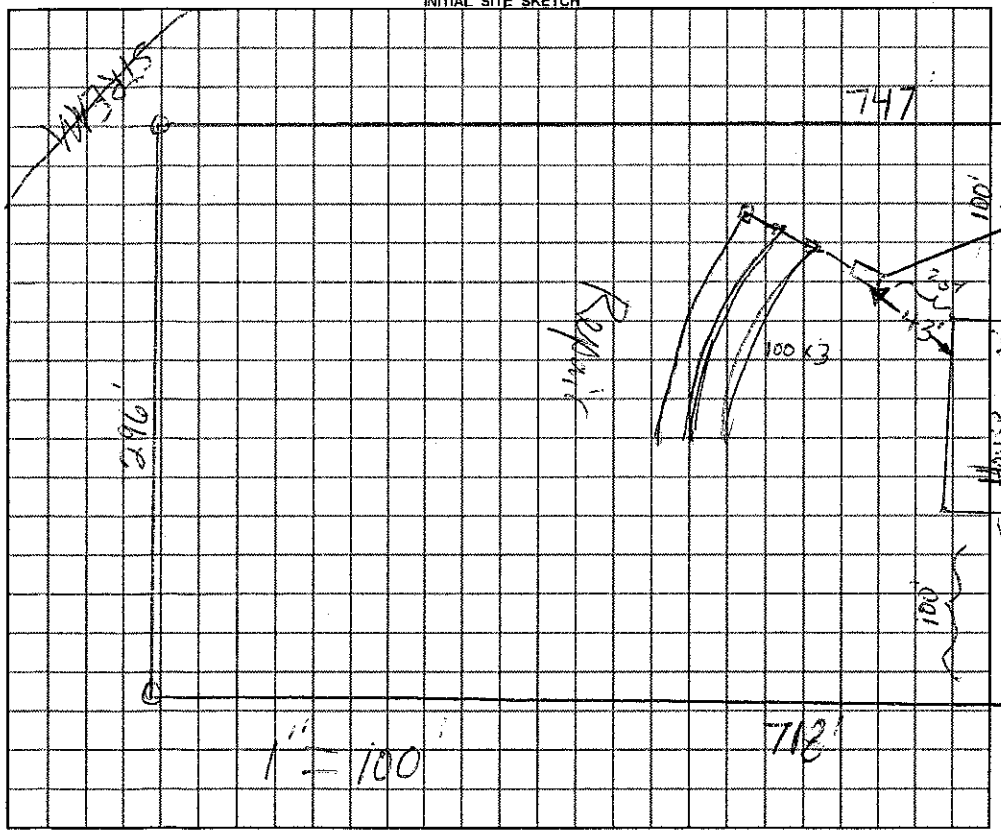

AS BUILT SKETCH

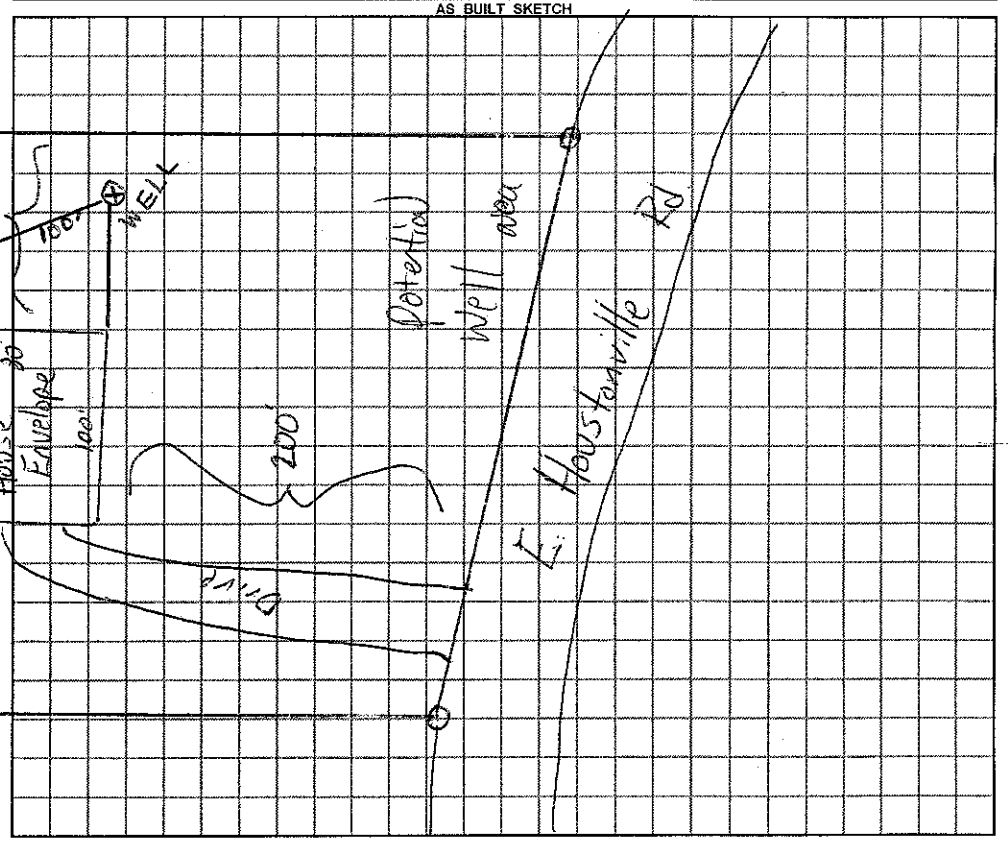

Permit can be suspended or revoked if any false information is supplied toward securing the permit / any unauthorized changes are made to the site / any unauthorized changes are made in the installation of the system.

☐ ***IMPROVEMENT PERMIT*** with plat valid without expiration. ☒ ***IMPROVEMENT PERMIT*** with plat valid without expiration. site plan valid 60 mo. ☒ ***AUTHORIZATION TO CONSTRUCT*** valid for period equal to IMPROVEMENT PERMIT--not to exceed 60 mo.

Owner / Applicant Signature: Date 1-24-12 Installed by: GUNTER GRADING CO.

IMPROVEMENT PERMIT by: REHS Date 1-20-12 OPERATION PERMIT by: #1377 REHS Date 4-3-12

AUTHORIZATION TO CONSTRUCT by: REHS Date 1-20-12 Existing System Inspected by: REHS Date

YOU SHOULD CONTACT A LOCATOR SERVICE PRIOR TO ANY EXCAVATION

White Copy – Environmental Health YELLOW COPY (Final) Owner / Applicant PINK COPY (Initial) Owner / Applicant