IREDELL COUNTY HEALTH DEPARTMENT

STATESVILLE 704-878-5305 MOORESVILLE 704-664-5281

IMPROVEMENT PERMIT / AUTHORIZATION TO CONSTRUCT / OPERATION PERMIT / EXISTING SYSTEM INSPECTION

PERMIT# 150125 PIN# 4882856e034 DATE 5-5-08

OWNER OR APPLICANT Kathleen Foster PHONE: Business _____ Home 702-546-5360

ADDRESS 329 Bowers Road Taumsey 28634

LOCATION 21N (TO) Hasken Wells RD (TO) Reavis RD Property on left 1mile 329 Reavis RD

SUBDIVISION _____ BLOCK / SECTION _____ LOT _____ LOT AREA 1.805 SITE CLASS. B DESIGN FLOW 360 L.T.A.R. _____

Septic Tank: 1000 Gallons; STB _____ Date _____

Pump Tank: _____ Gallons; PT _____ Date _____

Pump Make: _____ Model _____ Serial No. _____

Nitrification Field: No Fields ___ Square Feet _____ Linear Feet _____

No Lines 2 Trench Width 36" Max Trench Bottom Depth 36" Gravel Depth _____

☐ ~~New System~~ ☐ Repair ☐ Expansion System Type: I II III IV V VI

System Description: Gravel Gravity

Repair System Description: 25% Gravity

Maintenance Agreement Required: ☐ Yes ☐ No

☐ House/Mod. Home ☐ ~~Mobile Home~~ ☐ Business ☐ Other

No. Bedrooms 3 No. Persons 2 No. Employees ___


Water Supply: ☐ Individual ☐ Public ☐ Community

☐ Slab ☐ Crawl Space ☐ Basement w/plumbing ☐ Basement wo/plumbing


Comments:/Conditions:

Comments:/Conditions:

INITIAL SITE SKETCH

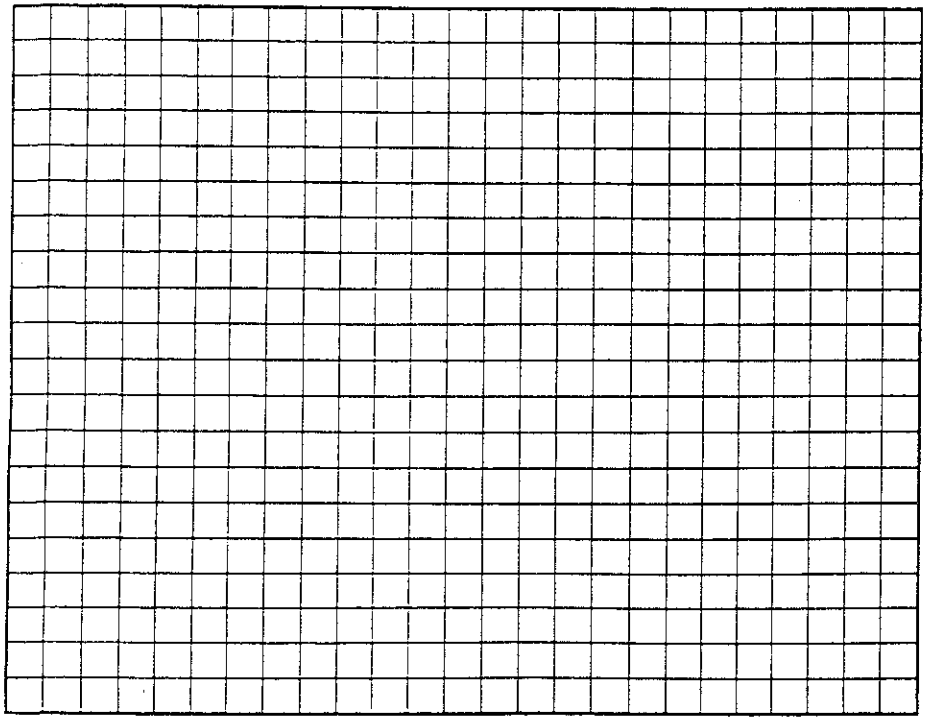

AS BUILT SKETCH

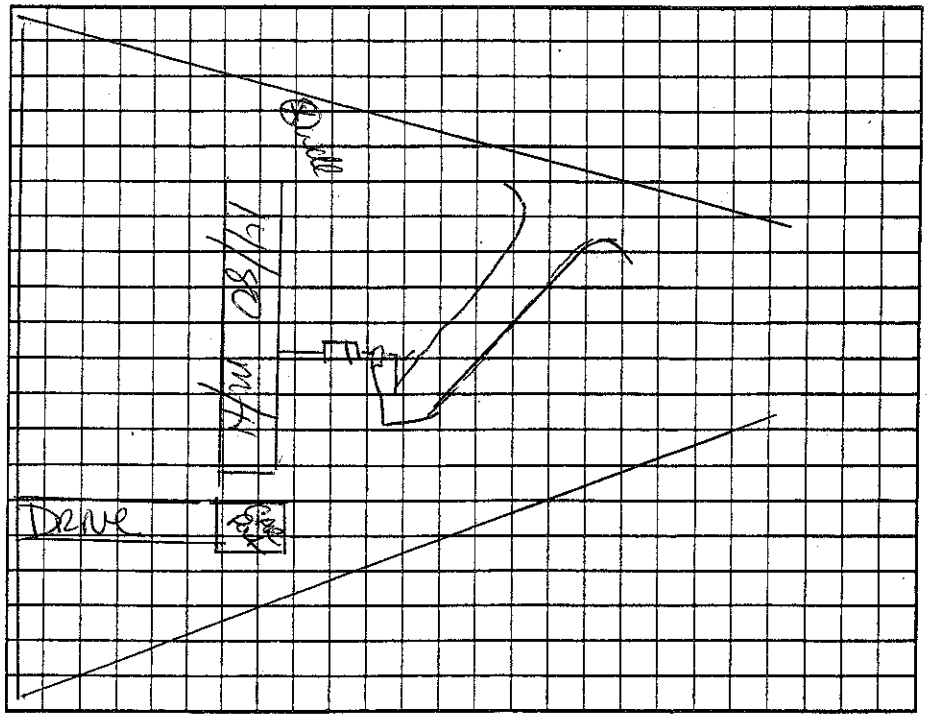

Permit can be suspended or revoked if any false information is supplied toward securing the permit/any unauthorized changes are made to the site/any unauthorized changes are made in the installation of the system. Improvement Permit with plat valid without expiration ☐ Improvement Permit with site plan valid for sixty months ☒ Authorization to Construct is valid for a period equal to that of Improvement Permit – not to exceed sixty months.

Signed: _____ date _____

Improvement Permit by: _____ date _____

Authorization to Construct by: _____ date _____

Installed by: _____

Operation Permit by: _____ date _____

Existing System Inspection by: _____ date 5-5-08

HEALTH DEPT. COPY: WHITE OWNER COPY (FINAL): YELLOW OWNER COPY (INITIAL): PINK