IREDELL COUNTY HEALTH DEPARTMENT

STATESVILLE 704-878-5305 MOORESVILLE 704-664-5281

IMPROVEMENT PERMIT / AUTHORIZATION TO CONSTRUCT / OPERATION PERMIT / EXISTING SYSTEM INSPECTION

PERMIT # 157038 PIN # 4882-85-~~8304,343~~ 7194 DATE 25 June 09

OWNER or APPLICANT Kathleen Foster PHONE: Business Home: (704) 546-5360

OWNER or APPLICANT ADDRESS 329 Reavis Rd Harmony

LOCATION / DIRECTIONS NW/21N TR Houstonville Rd TR Reavis Rd. 1mile on left.

SUBDIVISION BLOCK / SECTION LOT # LOT AREA 0.75Ac. DESIGN FLOW 360g/d L.T.A.R. 0.3g/ft²/d

Septic Tank 1000 Gallons: STB 620 Date 11-5-07

Pump Tank Gallons: P T Date

Pump Make Model Serial #

Nitrification Field No Fields 1 No Lines 4 Linear Feet 300

Trench Width 36" Max. Trench Bottom Depth 36" Gravel Depth

☑ New System ☐ Repair ☐ Expansion System Type I II III IV V VI

System Description: 25% Reduction

Repair System Description: 50% Reduction - Pump

Maintenance Agreement Required ☐ YES ☑ NO

☑ GRAVITY ☐ PRESSURE

☑ Residence No. Bedrooms 3 ☐ Business No. Persons ☐ Other No. Employees ☐ Slab ☑ Crawl Space ☐ Basement w/plumbing ☐ Basement w/o plumbing

Water Supply: ☑ Private ☐ Public ☐ Community

Comments / Conditions: Follow contour / Keep out of gullys. Honor setbacks.

Comments / Conditions: Fill installed

INITIAL SITE SKETCH

Please see Attached site sketch.

AS BUILT SKETCH

Installed as Drawn

Permit can be suspended or revoked if any false information is supplied toward securing the permit / any unauthorized changes are made to the site / any unauthorized changes are made in the installation of the system.

☐ *IMPROVEMENT PERMIT w / plat valid without expiration.* ☑ *IMPROVEMENT PERMIT w / site plan valid for 60 mos.* ☑ *AUTHORIZATION TO CONSTRUCT valid for period equal to IMPROVEMENT PERMIT-not to exceed 60 mo.*

Owner / Applicant Signature: Kathleen Foster Date 6-26-09

Improvement Permit by: [signature], R.S. Date 25 June 09

Authorzation to Construct by: [signature], R.S. Date 25 June 09

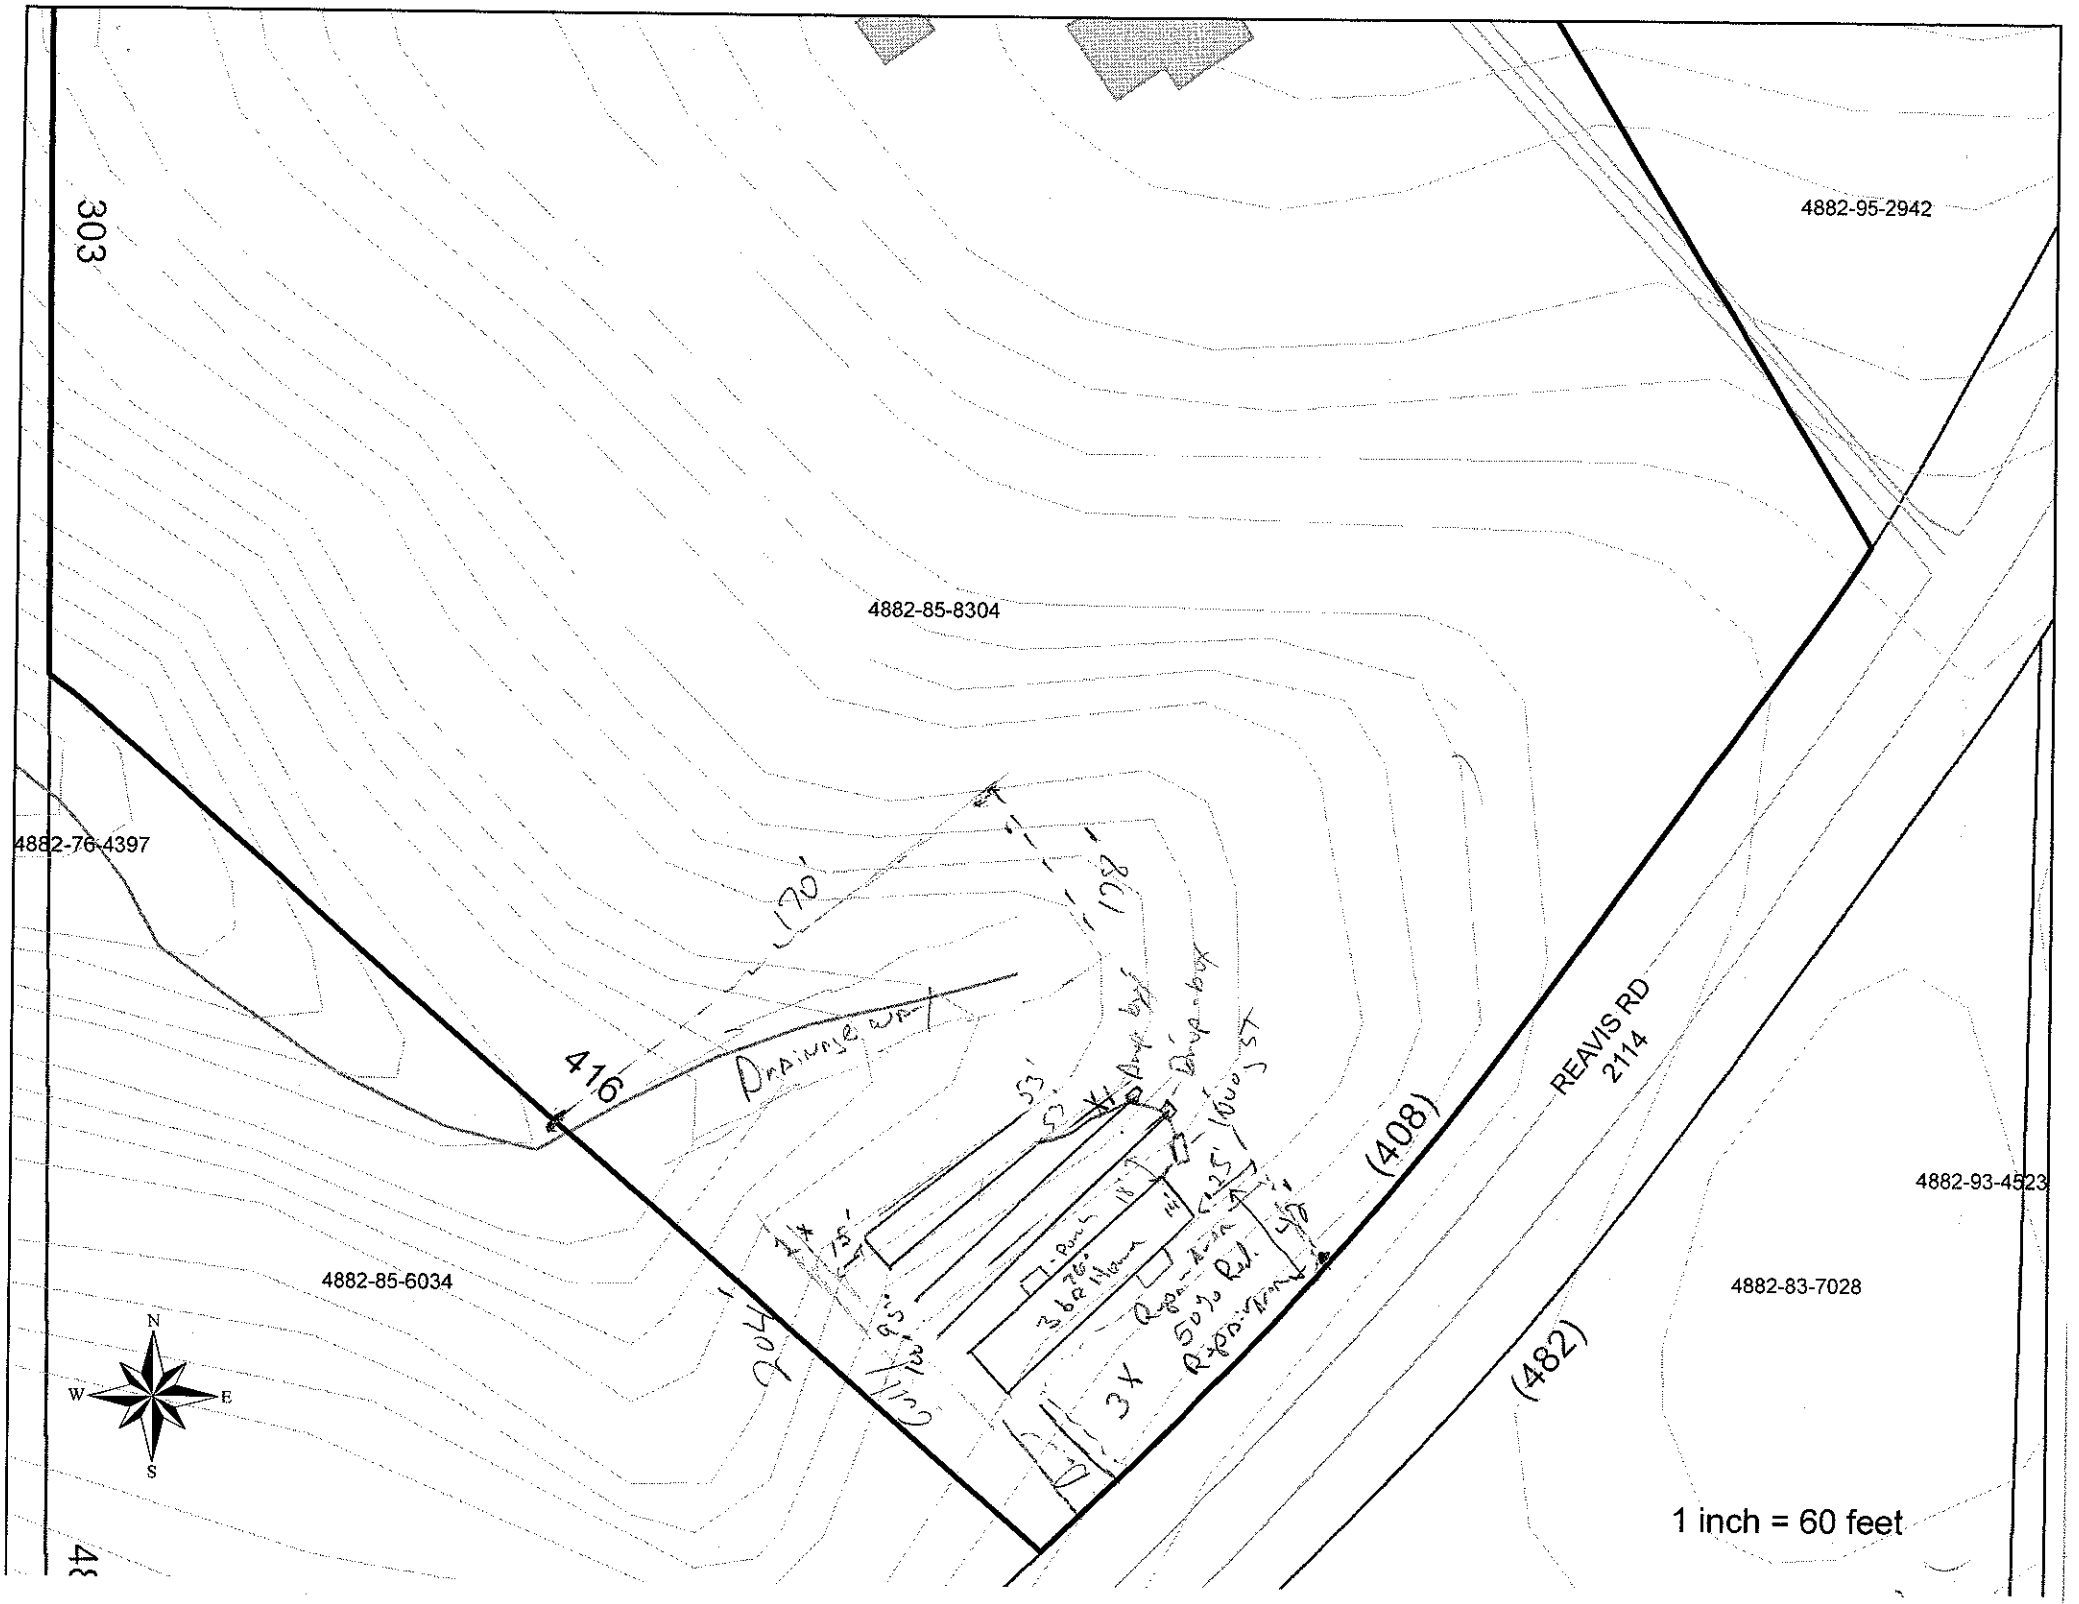
YOU SHOULD CONTACT A LOCATOR SERVICE PRIOR TO ANY EXCAVATION.

Installed by: GAS Gunter Grading

Operation Permit by: [signature], R.S. Date: 30 June 09

Existing System Inspected by: Date:

WHITE COPY Environmental Health YELLOW COPY (Final) Owner / Applicant PINK COPY (Initial) Owner / Applicant


303
4882-95-2942
4882-85-8304
4882-76-4397
170'
132'
416
Drainage way
53'
52'
3 br home
Pool
18'
125'
3X
Retaining wall
45'
(408)
REAVIS RD
2114
4882-93-4523
4882-85-6034
4882-83-7028
(482)
N
W
E
S
1 inch = 60 feet