IREDELL COUNTY HEALTH DEPARTMENT

STATESVILLE 704-878-5305 MOORESVILLE 704-664-5281

IMPROVEMENT PERMIT / CERTIFICATE OF COMPLETION / OPERATION PERMIT / EXISTING SYSTEM INSPECTION

PROPERTY DESCRIPTION NO. 16651 DATE 7/14/93 TAX MAP NO. 17J-A-38

OWNER OR CONTRACTOR HARVEY L. BECK PHONE: Business Home

ADDRESS Rt. 2, Box 236-C, HARMONY, NC 28634

LOCATION US 21 N, TR HOUSTONVILLE RD, TR REAVIS RD, ~0.5 MILE ON (L)

SUBDIVISION BLOCK / SECTION LOT LOT AREA AMPLE SITE CLASS PS L.T.A.R. B-

Water Supply: ✓ Individual ☐ Community ☐ Public WELL

Septic Tank: EXISTING Gallons, STB Date

Pump Tank: Gallons, PT Date

Nitrification Field: No Fields 1 Square Feet Linear Feet EXISTING

No Lines Trench Width Trench Depth Gravel Depth

☐ New System ☐ Repair System Type: I, II, III, IV, V

System Description: CONV. GRAVITY

Repair System Description: CONV. GRAVITY

Maintenance Agreement Required: ☐ Yes ✓ No

House/Mod Home / ✓ Mobile Home / Business / Other

No. Bedrooms 2 No. Bathrooms 1 No. Employees

Slab ✓ Crawl Space Basement w/plumbing Basement wo/plumbing

Garbage Disposal: ☐ Yes ✓ No

Auto Dishwasher: ✓ Yes ☐ No


Auto Washing Machine: ✓ Yes ☐ No

Other

Comments KEEP MH MINIMUM 5' FROM SEPTIC SYSTEM

INITIAL SITE SKETCH

AS BUILT SKETCH

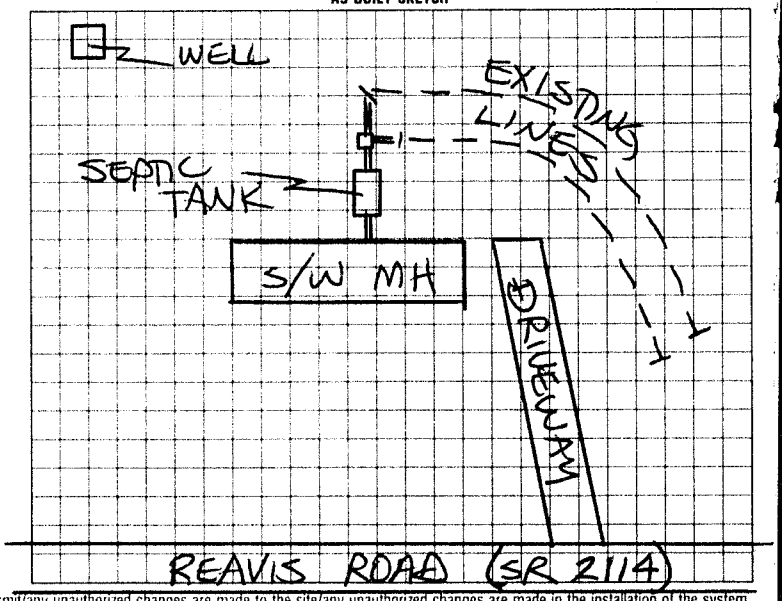

I understand that this permit can be suspended or revoked if any false information is supplied toward securing the permit/any unauthorized changes are made to the site/any unauthorized changes are made in the installation of the system. Improvement Permit is valid for 60 months from date of issuance.

Signed:

Improvement Permit by: date

Existing System Inspection by: STEVE HEDRICK date 7/14/93

Installed by

Certificate of Completion by date

Operation Permit by date

HEALTH DEPT COPY: WHITE INSPECTION COPY (FINAL) GREEN OWNER COPY (FINAL) YELLOW INSPECTION COPY (INITIAL) PINK OWNER COPY (INITIAL) GOLD