IREDELL COUNTY HEALTH DEPARTMENT

STATESVILLE 704-878-5305 MOORESVILLE 704-664-5281

IMPROVEMENT PERMIT / AUTHORIZATION TO CONSTRUCT / OPERATION PERMIT / EXISTING SYSTEM INSPECTION

PERMIT# REPAIR PIN# 4883-34-2033 DATE 4-12-05

OWNER OR CONTRACTOR BEECHER GROSE PHONE: Business Home 704-546-2447

ADDRESS 561 NORTH MEADOW ROAD, HARMONY, NC 28634

LOCATION US 21 NORTH, TR E. HOUSTONVILLE RD, TL / NORTH MEADOW RD, 1.7 MILES ON LEFT

SUBDIVISION BLOCK / SECTION LOT LOT AREA 453.08 ACRES SITE CLASS PS DESIGN FLOW 360 L.T.A.R. ~0.25 GPD/FT²

Septic Tank: EXISTING Gallons: STB Date

Pump Tank: Gallons: PT Date

Pump Make: Model Serial No.

Nitrification Field: No Fields 1 Square Feet 1200 Linear Feet 400

No Lines FIVE Trench Width 36" Max Trench Bottom Depth 36" Gravel Depth 12"±

☐ New System ☑ Repair System Type: I (II) III, IV, V, VI

System Description:

Repair System Description: CONVENTIONAL, GRAVITY

Maintenance Agreement Required: ☐ Yes ☑ No

☑ House/Mod. Home No. Bedrooms 2

☐ Mobile Home No. Bathrooms

☐ Business No. Employees

☐ Other W/SIX PERSONS


☐ Slab ☑ Crawl Space ☐ Basement w/plumbing ☐ Basement wo/plumbing

Water Supply: ☑ Individual ☐ Public ☐ Community

Comments:/Conditions: ① REPLACE EXISTING SEPTIC TANK IF NECESSARY. ② INSTALL LINER ON CONTOUR AS SHOWN USING 12" ± STONE

Comments:/Conditions:

INITIAL SITE SKETCH

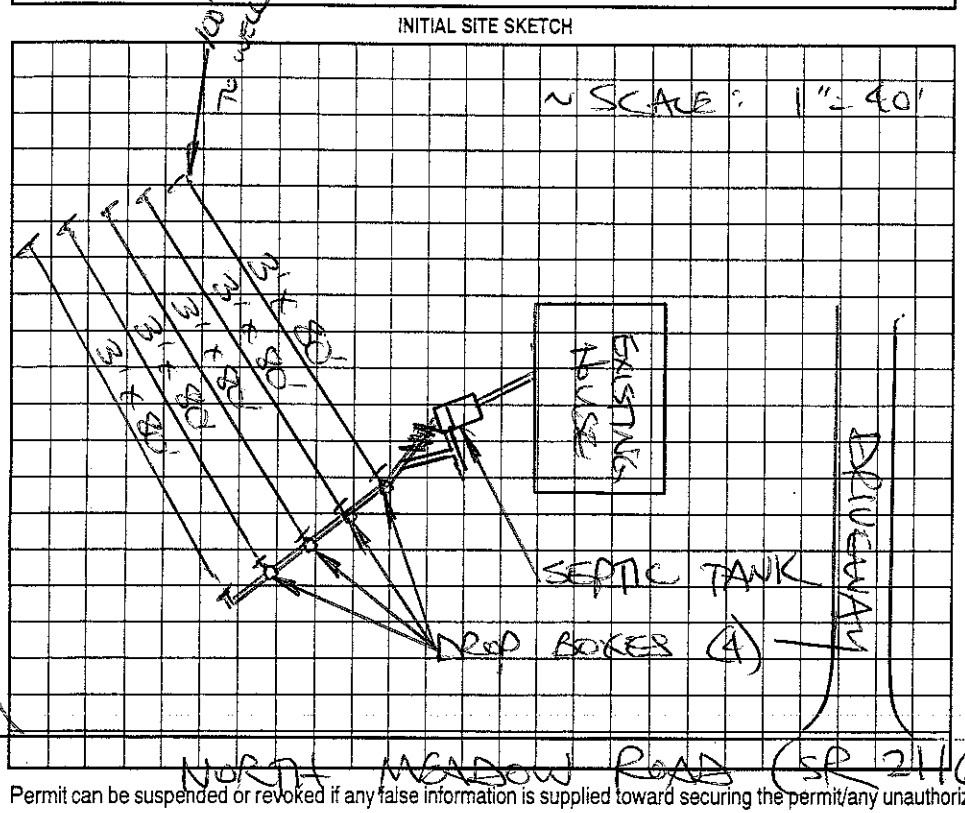

AS BUILT SKETCH

SYSTEM REPAIRED ACCORDING TO INITIAL SITE SKETCH

Permit can be suspended or revoked if any false information is supplied toward securing the permit/any unauthorized changes are made to the site/any unauthorized changes are made in the installation of the system. Improvement Permit with plat valid without expiration. Improvement Permit with site plan valid for sixty months. Authorization to Construct is valid for a period equal to that of Improvement Permit – not to exceed sixty months.

Signed: Sammy Reams date 4-12-05 Installed by: SAMMY REAMS

Improvement Permit by: STEVE HEDRICK date 4-12-05 Operation Permit by: STEVE HEDRICK date 5-3-05

Authorization to Construct by: STEVE HEDRICK date 4-12-05 Existing System Inspection by: date

HEALTH DEPT. COPY: WHITE OWNER COPY (FINAL): YELLOW OWNER COPY (INITIAL): PINK