IREDELL COUNTY HEALTH DEPARTMENT - *ENVIRONMENTAL HEALTH* ☒ STATESVILLE OFFICE 704-878-5305 ☐ MOORESVILLE OFFICE 704-664-5281

IMPROVEMENT PERMIT / AUTHORIZATION TO CONSTRUCT / OPERATION PERMIT / EXISTING SYSTEM INSPECTION

PERMIT # 165903 PIN # 4883-50-7914 DATE MARCH 30, 2011

OWNER HOOT-N-HOLLAR FARM APPLICANT: SAME PHONE: Home/Cell # 704-546-5400 Business #

SITE ADDRESS 694 E. HOUSTONVILLE ROAD, HARMONY OWNER / APPLICANT ADDRESS SAME

SITE DIRECTIONS US 21 N, TR E. HOUSTONVILLE RD, TL NORTH MEADOW RD, 0.8 MILE ON RIGHT, 1400' BACK OFF ROAD


SUBDIVISION N/A BLOCK / SECTION N/A LOT # N/A LOT AREA 111.979 ACRES DESIGN FLOW 750 L.T.A.R. 0.25 GPD/FT²

GREASE TRAP 1000 GALLONS

Septic Tank 1500	Gallons: STB 390	Date 1-29-11	☑ New System ☐ Repair ☐ Expansion System Type I II (III) IV V VI	☐ Residence	No. Bedrooms 150 SEAT BANQUET HALL @ 5 GPD/SEAT	Water Supply
Pump Tank 1500	Gallons: P T 353	Date 12-26-10	System Description: CONVENTIONAL, PRESSURE MANIFOLD	☑ Business	No. Persons	☐ Private
Pump Make	Model	Serial #	Repair System Description: CONVENTIONAL, PRESS. MANIFOLD	☐ Other	No. Employees	☑ Public, 1700 GALLONS
No. Nitrification Fields: 1	No. Lines 7	Linear Feet 1000	Maintenance Agreement Required ☐ YES ☑ NO	☑ Slab	☐ Crawl Space	☐ Community
Trench Width 36"	Max. Trench Bottom Depth 36"	Gravel Depth 12"	☐ GRAVITY ☑ PRESSURE	☐ Basement w/plumbing	☐ Basement w/o plumbing	

Comments / Conditions ① SEE ATTACHED SHEETS FOR PUMP AND PRESSURE MANIFOLD REQUIREMENTS ② NO REDUCTIONS SHALL BE GRANTED WHEN INNOVATIVE, MODIFIED, OR ACCEPTED SYSTEMS ARE USED.

INITIAL SITE SKETCH

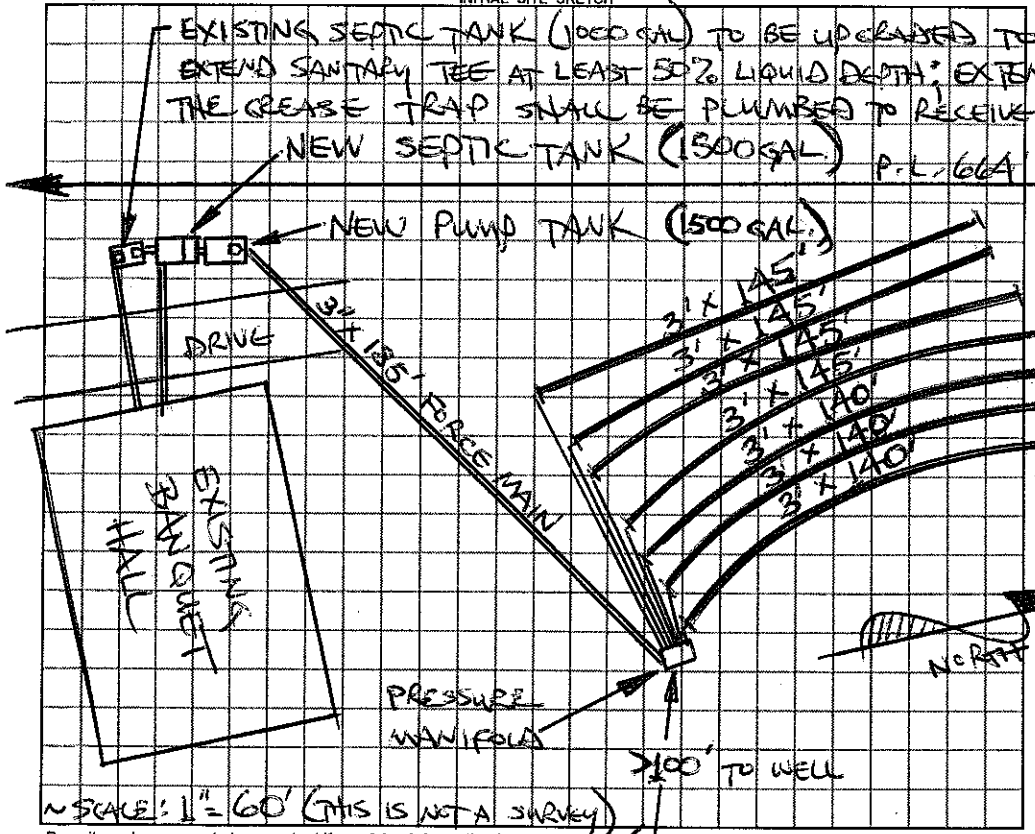

AS BUILT SKETCH

Permit can be suspended or revoked if any false information is supplied toward securing the permit / any unauthorized changes are made to the site / any unauthorized changes are made in the installation of the system.

☐ *IMPROVEMENT PERMIT with plat valid without expiration.* ☑ *IMPROVEMENT PERMIT with ~~plat valid without expiration~~ site plan valid 60 mo.* ☑ *AUTHORIZATION TO CONSTRUCT* valid for period equal to IMPROVEMENT PERMIT--not to exceed 60 mo.

Owner / Applicant Signature: RAPP Date 4-1-11 Installed by: Gunther Grad. '09

IMPROVEMENT PERMIT by: R. STEVE HENDRICK REHS Date 3/30/2011 OPERATION PERMIT by: REHS Date 4-19-11

AUTHORIZATION TO CONSTRUCT by: STEVE HENDRICK REHS Date 3/30/2011 Existing System Inspected by: REHS Date

YOU SHOULD CONTACT A LOCATOR SERVICE PRIOR TO ANY EXCAVATION

EXISTING WELL SITE

White Copy – Environmental Health YELLOW COPY (Final) Owner / Applicant PINK COPY (Initial) Owner / Applicant