IREDELL COUNTY HEALTH DEPARTMENT

STATESVILLE 704-878-5305 MOORESVILLE 704-664-5281

IMPROVEMENT PERMIT / AUTHORIZATION TO CONSTRUCT / OPERATION PERMIT / EXISTING SYSTEM INSPECTION

PERMIT# 127859 PIN# 4883-52-2192 3 DATE 6-20-05

OWNER OR CONTRACTOR SCOTTY & NICOLETTE BROWN PHONE: Business (704) 872-8171 X178 Home (704) 881-2378

ADDRESS 108 DAWNWOOD LANE STATESVILLE, NC 28677

LOCATION I-77 N TR HWY 901 TL EAGLE MILLS TR E HOUSTONVILLE TL N. MEADOW GO 1.3 MILES PROP ON RIGHT

SUBDIVISION _____ BLOCK / SECTION _____ LOT _____ LOT AREA 17.543 SITE CLASS PS DESIGN FLOW 360 L.T.A.R. 0.25 GAD/FT

Septic Tank: 1000 Gallons; STB 1012 Date 3-7-05
Pump Tank: _____ Gallons; PT _____ Date _____
Pump Make: _____ Model _____ Serial No. _____
Nitrification Field: No Fields 1 Square Feet 1440 Linear Feet 360
No Lines FOUR (4) Trench Width 36" Max Trench Bottom Depth 24" Gravel Depth N/A

☑ New System ☐ Repair System Type: I (II) III, IV, V, VI
System Description: GRAVITY 25% REDUCTION
Repair System Description: SAME
Maintenance Agreement Required: ☐ Yes ☑ No

☑ House/Mod. Home No. Bedrooms 3
☐ Mobile Home No. Bathrooms ____
☐ Business No. Employees ____
☐ Other _____


☐ Slab ☑ Crawl Space ☐ Basement w/plumbing ☐ Basement wo/plumbing

Water Supply: ☑ Individual ☐ Public ☐ Community


Comments:/Conditions ① INSTALL SYSTEM NO DEEPER THAN 24" ON CONTOUR ② INSTALL SUBSURFACE INTERCEPTOR DRAIN AT LEAST 36" TO DAYLIGHT ③ MAINTAIN SETBACKS W/ SUBSURFACE DRAIN

Comments:/Conditions: Yellow tuff-tite, filter & Septic tank marker

INITIAL SITE SKETCH

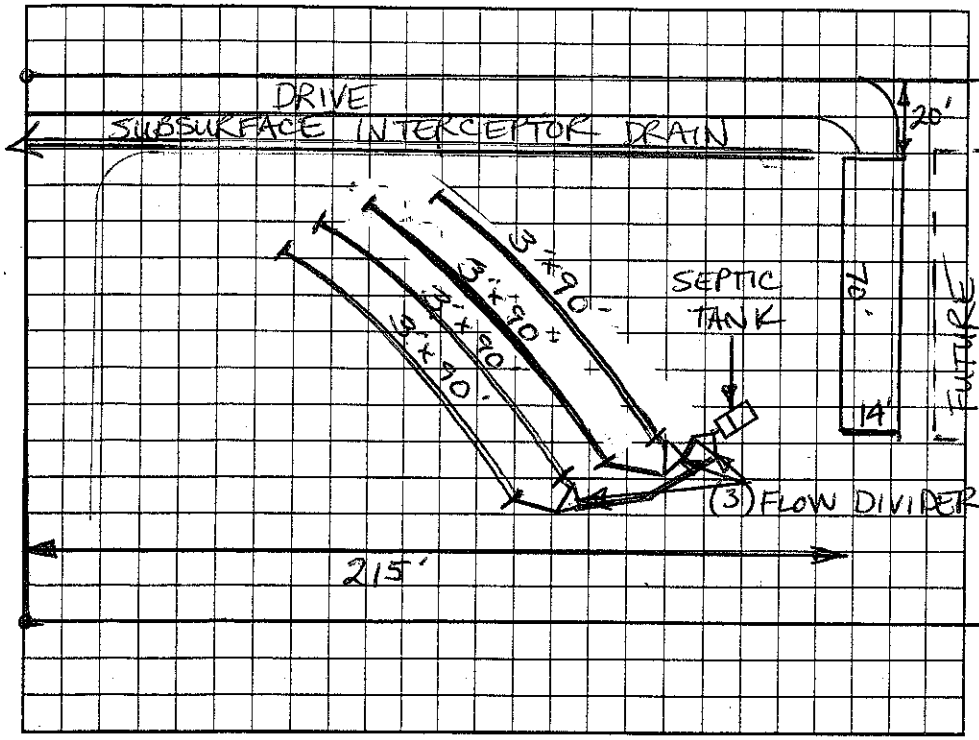

AS BUILT SKETCH

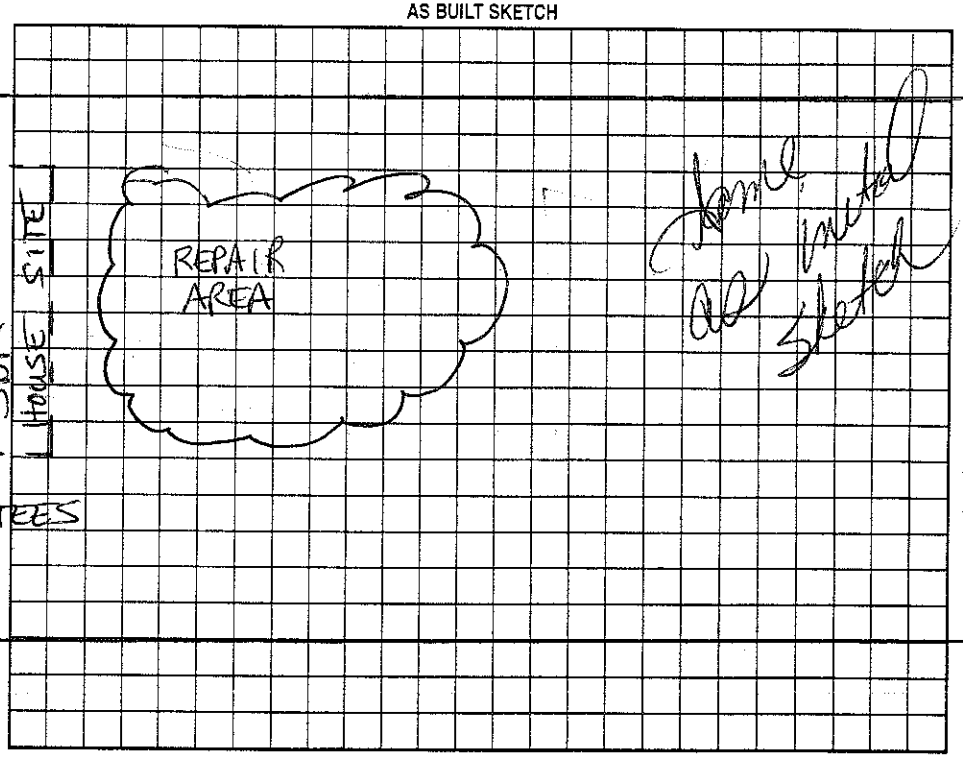

Permit can be suspended or revoked if any false information is supplied toward securing the permit/any unauthorized changes are made to the site/any unauthorized changes are made in the installation of the system. Improvement Permit with plat valid without expiration. Improvement Permit with site plan valid for sixty months. Authorization to Construct is valid for a period equal to that of Improvement Permit – not to exceed sixty months.

Signed: _____ date 6-21-05 Installed by: H-1 Backhoe

Improvement Permit by: Christopher M. Sherrill, RS, LSS date 6-20-05 Operation Permit by: Kelly Cox date 6-25-05

Authorization to Construct by: Christopher M. Sherrill, RS, LSS date 6-21-05 Existing System Inspection by: _____ date _____

HEALTH DEPT. COPY: WHITE OWNER COPY (FINAL): YELLOW OWNER COPY (INITIAL): PINK