IREDELL COUNTY HEALTH DEPARTMENT

STATESVILLE 704-878-5305 (1) MOORESVILLE 704-664-5281

IMPROVEMENT PERMIT / AUTHORIZATION TO CONSTRUCT / OPERATION PERMIT / EXISTING SYSTEM INSPECTION

PERMIT# 116867 PIN# 4883 - 52 - 3329 DATE 11-17-03

OWNER OR CONTRACTOR FLEETWOOD Homes of STATESVILLE PHONE: Business 704-872-0179 Home

ADDRESS 1270 NORTHSIDE ARIVE, STATESVILLE, NC 28677

LOCATION US 21 N, TR E. HOUSTONVILLE RD, TL NORTH MEADOW ROAD, N 1.0 MILE ON RIGHT

SUBDIVISION BLOCK / SECTION LOT LOT AREA 19.543 ACRES SITE CLASS. PS DESIGN FLOW 480 L.T.A.R. 0.35 GPD/FT²

Septic Tank: 1000 Gallons; STB 1012 Date 6-18-03
Pump Tank: Gallons; PT Date
Pump Make: Model Serial No.
Nitrification Field: No Fields 1 Square Feet 1380 Linear Feet 460
No Lines FOUR Trench Width 36" Max Trench Bottom Depth 36" Gravel Depth 12"

☑ New System ☐ Repair System Type: I, (II), III, IV, V, VI
System Description: CONVENTIONAL, GRAVITY
Repair System Description: 25% REDUCTION, GRAVITY (pump)
Maintenance Agreement Required: ☐ Yes ☑ No


☐ House/Mod. Home No. Bedrooms 4
☑ Mobile Home No. Bathrooms 2
☐ Business No. Employees
☐ Other
☐ Slab ☑ Crawl Space ☐ Basement w/plumbing ☐ Basement wo/plumbing

Water Supply: ☑ Individual ☐ Public ☐ Community
WELL

Comments:/Conditions: KEEP SYSTEM MINIMUM 100 FEET FROM SYSTEM

Comments:/Conditions: SEPTIC TANK WITH MARKER INSTALLED USING "TUFFTITE" FILTER

INITIAL SITE SKETCH

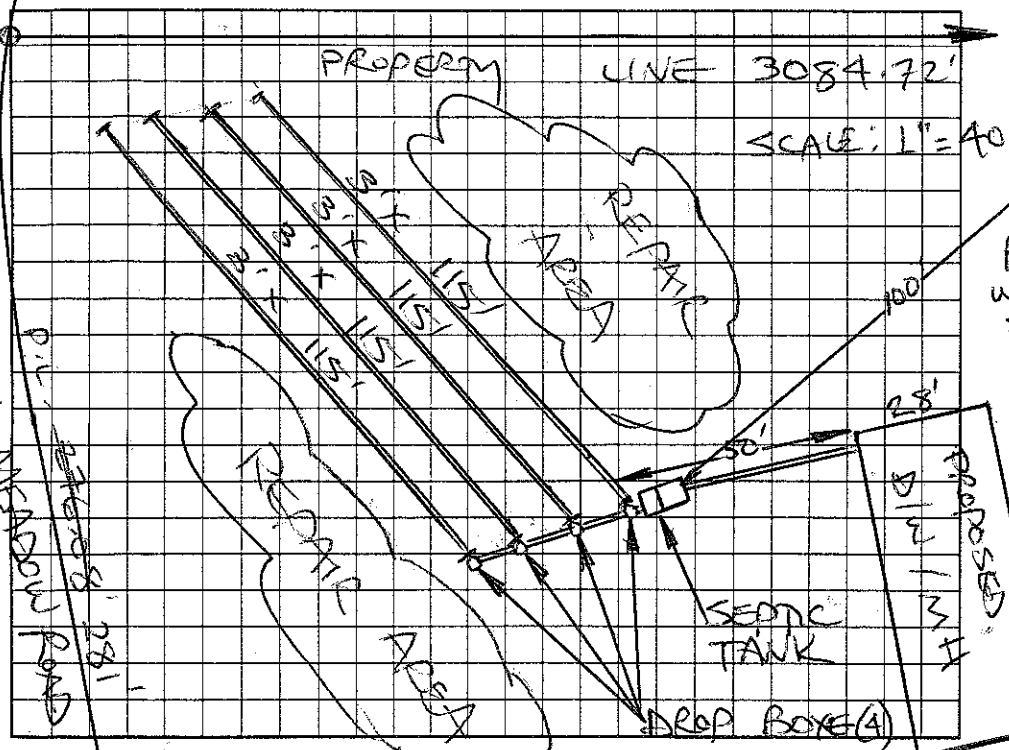

AS BUILT SKETCH

SYSTEM INSTALLED ACCORDING TO INITIAL SITE SKETCH

Permit can be suspended or revoked if any false information is supplied toward securing the permit/any unauthorized changes are made to the site/any unauthorized changes are made in the installation of the system. Improvement Permit with plat valid without expiration. Improvement Permit with site plan valid for sixty months. Authorization to Construct is valid for a period equal to that of Improvement Permit – not to exceed sixty months.

Signed: + Bryan Lynn date 11/17/03 Installed by: CRAIG THOMPSON

Improvement Permit by: STEVE HEDRICK date 11-17-03 Operation Permit by: STEVE HEDRICK date 12-1-03

Authorization to Construct by: STEVE HEDRICK date 11-17-03 Existing System Inspection by: date

HEALTH DEPT. COPY: WHITE OWNER COPY (FINAL): YELLOW OWNER COPY (INITIAL): PINK