10:00

IREDELL COUNTY HEALTH DEPARTMENT

STATESVILLE 704-878-5305 (cr) MOORESVILLE 704-664-5281

IMPROVEMENT PERMIT / AUTHORIZATION TO CONSTRUCT / OPERATION PERMIT / EXISTING SYSTEM INSPECTION

PERMIT # 161519 PIN # 4883-76-2628 DATE 7-6-10

OWNER or APPLICANT Harry D Johnson PHONE: Business 704 902 0825 Home:

OWNER or APPLICANT ADDRESS 709 N. Meadow Rd Harmony

LOCATION / DIRECTIONS Hwy 21 N, (R) on E. Houstonville Rd, (L) on N. Meadow Rd., 2nd Chickenhouse on (L)

SUBDIVISION n/a BLOCK / SECTION n/a LOT # n/a LOT AREA 12.05 DESIGN FLOW 240 L.T.A.R. -3

Septic Tank 1000 Gallons: STB 1012 Date 3-23-09

Pump Tank ____ Gallons: P T ____ Date ____

Pump Make ____ Model ____ Serial # ____

Nitrification Field No Fields 1 No Lines 1 Linear Feet 200

Trench Width 36" Max. Trench Bottom Depth 36" Gravel Depth n/a

☒ New System ☐ Repair ☐ Expansion System Type I II III IV V VI

System Description: 25% Reduction Gravity

Repair System Description: 25% Reduction Gravity

Maintenance Agreement Required ☐ YES ☒ NO

☒ GRAVITY ☐ PRESSURE

☒ Residence No. Bedrooms 2

☐ Business No. Persons ____

☐ Other No. Employees ____

☐ Slab ☐ Crawl Space


☐ Basement w/plumbing ☐ Basement w/o plumbing

Water Supply: ☒ Private ☐ Public ☐ Community

Comments / Conditions

Comments / Conditions

INITIAL SITE SKETCH

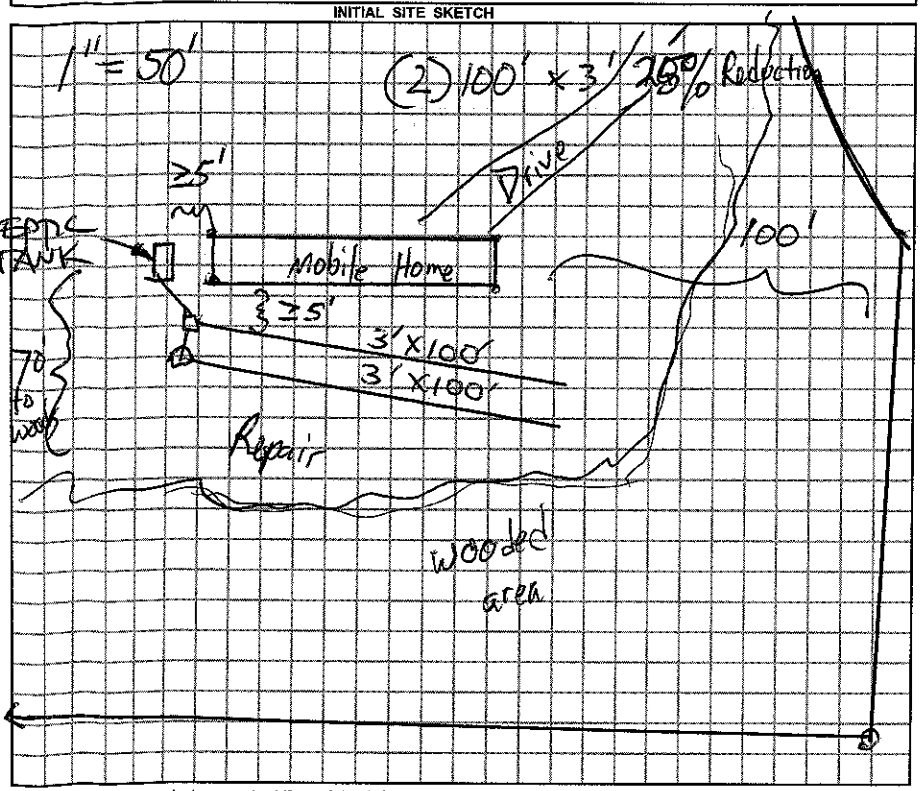

AS BUILT SKETCH

Permit can be suspended or revoked if any false information is supplied toward securing the permit / any unauthorized changes are made to the site / any unauthorized changes are made in the installation of the system.

☐ *IMPROVEMENT PERMIT w / plat valid without expiration.* ☒ *IMPROVEMENT PERMIT w / site plan valid for 60 mos.* ☒ *AUTHORIZATION TO CONSTRUCT valid for period equal to IMPROVEMENT PERMIT-not to exceed 60 mo.*

Owner / Applicant Signature: x Harry Dean Johnson Date 7-7-10

Improvement Permit by: [signature] Date 7-6-10

Authorization to Construct by: [signature] Date 7-6-10

Installed by: Hunter Grading

Operation Permit by: [signature] Date: 7-9-10

Existing System Inspected by: ____ Date: ____

U SHOULD CONTACT A LOCATOR SERVICE PRIOR TO ANY EXCAVATION.

WHITE COPY Environmental Health YELLOW COPY (Final) Owner / Applicant PINK COPY (Initial) Owner / Applicant