IREDELL COUNTY HEALTH DEPARTMENT

STATESVILLE 704-878-5305 MOORESVILLE 704-664-5281

IMPROVEMENT PERMIT / CERTIFICATE OF COMPLETION / OPERATION PERMIT / EXISTING SYSTEM INSPECTION

PROPERTY DESCRIPTION NO. 20892 DATE 4/18/95 TAX MAP NO. 17P-A-53

OWNER OR CONTRACTOR ROBIN JOHNSON PHONE: Business _____ Home 546-2689 Watershed: ☐ Yes ☑ No WS-III-BW

ADDRESS 697 NORTH MEADOW RD, HARMONY, NC 28634

LOCATION US 21 N, TR HOUSTONVILLE RD, CTY, NORTH MEADOW RD TO AIRY RD 2ND DWELLING ON LEFT

SUBDIVISION _____ BLOCK / SECTION _____ LOT _____ LOT AREA 11.6 AC SITE CLASS. F5 DESIGN FLOW 360 L.T.A.R. EXISTING

Septic Tank: EXISTING Gallons; STB _____ Date _____

Pump Tank: _____ Gallons; PT _____ Date _____

Pump Make: _____ Model _____ Serial No. _____

Nitrification Field: No Fields ___ Square Feet _____ Linear Feet EXISTING

No Lines _____ Trench Width _____ Max Trench Bottom Depth _____ Gravel Depth _____

☐ New System ☐ Repair System Type: ☐ I, II, IV, V, VI

System Description: CONV, GRAVITY

Repair System Description: CONV, GRAVITY

Maintenance Agreement Required: ☐ Yes ☑ No

☐ House/Mod. Home ☑ Mobile Home ☐ Business ☐ Other _____

No. Bedrooms 3 No. Bathrooms 2 No. Employees ___

☐ Slab ☑ Crawl Space ☐ Basement w/plumbing ☐ Basement wo/plumbing


Water Supply: ☑ Individual ☐ Community ☐ Public WELL

Comments:

Comments: KEEP MH MINIMUM 5' FROM SYSTEM

INITIAL SITE SKETCH

AS BUILT SKETCH

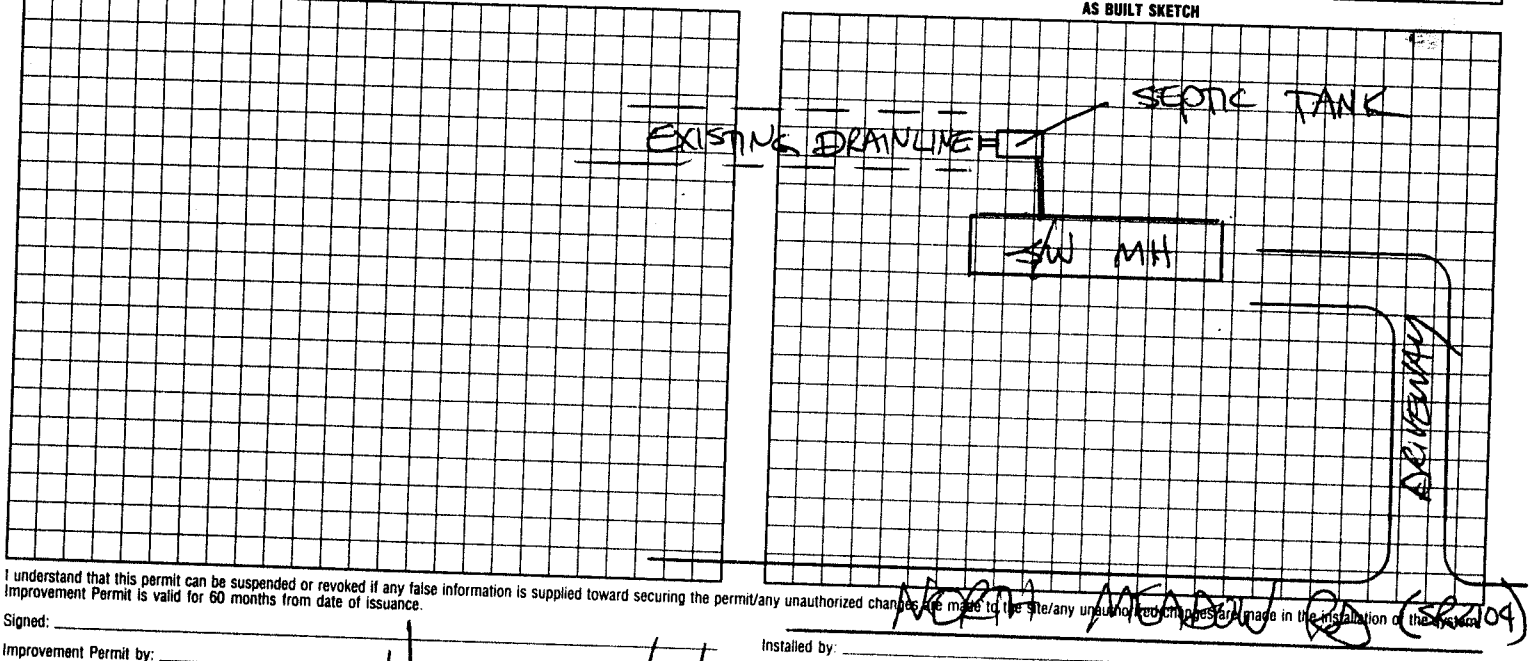

I understand that this permit can be suspended or revoked if any false information is supplied toward securing the permit/any unauthorized changes are made to the site/any unauthorized improvements are made in the installation of the system. Improvement Permit is valid for 60 months from date of issuance.

Signed: _____

Improvement Permit by: _____ date _____

Existing System Inspection by: STEVE HENDRICK date 4/18/95

Installed by: _____

Certificate of Completion by: _____ date _____

Operation Permit by: _____ date _____

HEALTH DEPT. COPY: WHITE INSPECTION COPY (FINAL): GREEN OWNER COPY (FINAL): YELLOW INSPECTION COPY (INITIAL): PINK OWNER COPY (INITIAL): GOLD