IREDELL COUNTY HEALTH DEPARTMENT - *ENVIRONMENTAL HEALTH* ☐ STATESVILLE OFFICE 704-878-5305 ☐ MOORESVILLE OFFICE 704-664-5281

IMPROVEMENT PERMIT / AUTHORIZATION TO CONSTRUCT / OPERATION PERMIT / EXISTING SYSTEM INSPECTION

PERMIT # 1689 88 PIN # 4884-01-9639 DATE 3 November 2011

OWNER James Haynes APPLICANT: PHONE: Home/Cell # (336) 466-1372 Business #

SITE ADDRESS 5048 Harmony Hwy OWNER / APPLICANT ADDRESS


SITE DIRECTIONS Harmony Hwy Almost to Yadkin Co. On Rt. before Anthony Rd.

SUBDIVISION BLOCK / SECTION LOT # LOT AREA 1.57 ac DESIGN FLOW 360 gpd L.T.A.R. 0.35/FT/d

Septic Tank	Exist.	Gallons: STB		Date	☐ New System	☐ Repair	☑ Expansion System	Type I II (III) IV V VI	☒ Residence	No. Bedrooms 3	Water Supply
Pump Tank		Gallons: P T		Date	System Description: 25% Reduction				☐ Business	No. Persons	☒ Private
Pump Make		Model		Serial #	Repair System Description: 25% Reduction				☐ Other	No. Employees	☐ Public
No. Nitrification Fields: 1		No. Lines 2		Linear Feet 100'	Maintenance Agreement Required ☐ YES ☒ NO				☐ Slab	☒ Crawl Space	☐ Community
Trench Width 36"		Max. Trench Bottom Depth 24"		Gravel Depth N/A	☑ GRAVITY ☐ PRESSURE				☐ Basement w/plumbing	☐ Basement w/o plumbing	

Comments / Conditions: Keep Home 5' from existing system. Add 100' of 25% Reduction. Meet all setback requirements.

INITIAL SITE SKETCH

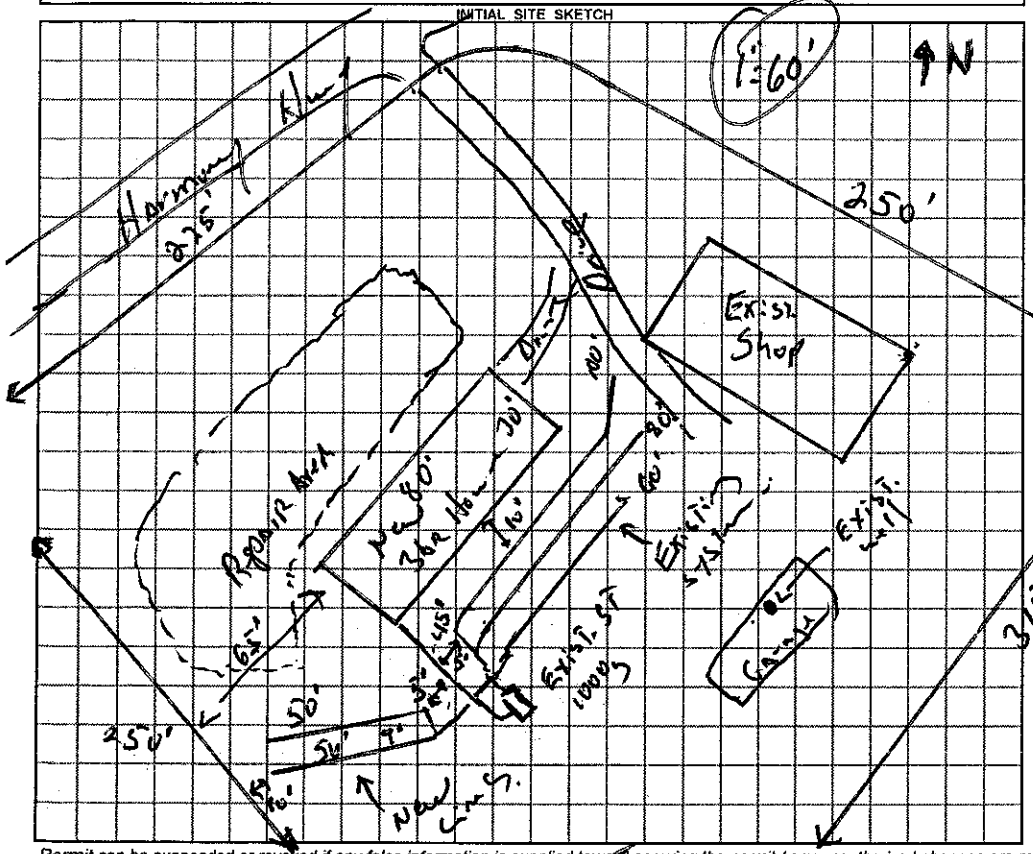

AS BUILT SKETCH

Permit can be suspended or revoked if any false information is supplied toward securing the permit / any unauthorized changes are made to the site / any unauthorized changes are made in the installation of the system.

☐ ***IMPROVEMENT PERMIT*** with plat valid without expiration. ☑ ***IMPROVEMENT PERMIT*** with ~~plat valid without expiration.~~ site plan valid 60 mo. ☑ ***AUTHORIZATION TO CONSTRUCT*** valid for period equal to IMPROVEMENT PERMIT--not to exceed 60 mo.

Owner / Applicant Signature: James Haynes Date 11-17-11 Installed by: Sammy Revis

IMPROVEMENT PERMIT by: REHS Date 3 Nov. 11 OPERATION PERMIT by: REHS Date 4-3-12

AUTHORIZATION TO CONSTRUCT by: REHS Date 3 Nov. 11 Existing System Inspected by: REHS Date

YOU SHOULD CONTACT A LOCATOR SERVICE PRIOR TO ANY EXCAVATION

White Copy – Environmental Health YELLOW COPY (Final) Owner / Applicant PINK COPY (Initial) Owner / Applicant