IREDELL COUNTY HEALTH DEPARTMENT

THIS PERMIT REPLACES EXPIRED PERMIT ISSUED 5-7-01

STATESVILLE 704-878-5305 MOORESVILLE 704-664-5281

IMPROVEMENT PERMIT / AUTHORIZATION TO CONSTRUCT / OPERATION PERMIT / EXISTING SYSTEM INSPECTION

PERMIT# REPAIR PIN# 4884-02-3326 DATE 12-21-06

OWNER OR APPLICANT LUTHER F. MILLER PHONE: Business 336-244-3599 Home 336-468-2668

ADDRESS 2644 WALKERS BRANCH ROAD HAMPTONVILLE, NC 27020

LOCATION US21 NORTH, ON LEFT PAST BARNARD MILL ROAD AT BOX #5021

SUBDIVISION _____ BLOCK / SECTION _____ LOT _____ LOT AREA 3.4 ACRES SITE CLASS. PS DESIGN FLOW 360 L.T.A.R. 0.30 GPD/FT²

Septic Tank: EXISTING Gallons: STB _____ Date _____

Pump Tank: _____ Gallons: PT _____ Date _____

Pump Make: _____ Model _____ Serial No. _____

Nitrification Field: No Fields 1 Square Feet 600 Linear Feet 200

No Lines THREE Trench Width 36" Max Trench Bottom Depth 36"

☐ New System ☑ Repair ☐ Expansion System Type: I II III IV V VI

System Description: _____

Repair System Description: CONVENTIONAL, GRAVITY

Maintenance Agreement Required: ☐ Yes ☑ No

Gravel Depth 18" ☑ Gravity ☐ Pressure

☑ House/Mod. Home ☐ Mobile Home ☐ Business ☐ Other

No. Bedrooms 3 No. Persons ____ No. Employees ____


Water Supply: ☑ Individual ☐ Public ☐ Community WELL

☐ Slab ☑ Crawl Space ☐ Basement w/plumbing ☐ Basement wo/plumbing

Comments:/Conditions: INSTALL TRENCHES ON CONTOUR AS FLAGGED USING 18" STONE. REPLACE SANITARY TEE IN SEPTIC TANK.

Comments:/Conditions:

INITIAL SITE SKETCH

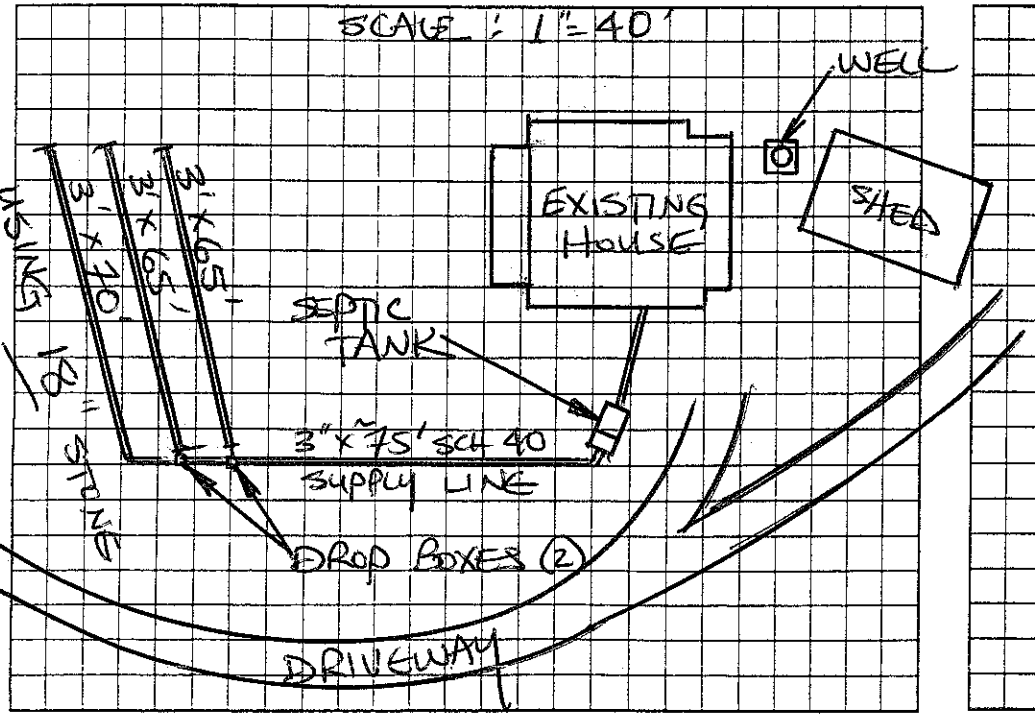

AS BUILT SKETCH

Permit can be suspended or revoked if any false information is supplied toward securing the permit/any unauthorized changes are made to the site/any unauthorized changes are made in the installation of the system. Improvement Permit with plat valid without expiration ☐ Improvement Permit with site plan valid for sixty months ☑ Authorization to Construct is valid for a period equal to that of Improvement Permit – not to exceed sixty months.

Signed: L. F. Miller date 12-21-06 Installed by: Nixon's Backhoe

Improvement Permit by: STEVE HEDRICK date 12-21-06 Operation Permit by: James date 12-28-06

Authorization to Construct by: STEVE HEDRICK date 12-21-06 Existing System Inspection by: _____ date _____

HEALTH DEPT. COPY: WHITE OWNER COPY (FINAL): YELLOW OWNER COPY (INITIAL): PINK