IREDELL COUNTY HEALTH DEPARTMENT

STATESVILLE 704-878-5305 MOORESVILLE 704-664-5281

IMPROVEMENT PERMIT / CERTIFICATE OF COMPLETION / OPERATION PERMIT / EXISTING SYSTEM INSPECTION

PROPERTY DESCRIPTION NO. 68648 DATE 9-5-97 TAX MAP NO. 4884119713 Watershed: ☑ Yes ☐ No

OWNER OR CONTRACTOR Chris Flanagan PHONE: Business _____ Home _____ WSIII (BOW)

ADDRESS 5048 Old Hwy 21 Hamptonville N.C.

LOCATION 21W To Yadkin Co. line TR Anthony Rd 1/4 mi left

SUBDIVISION _____ BLOCK / SECTION _____ LOT _____ LOT AREA 11 acres SITE CLASS. 1 PS DESIGN FLOW 360 L.T.A.R. .35

Septic Tank: 1000 Gallons; STB 10 12 Date 9-13-97

Pump Tank: _____ Gallons; PT _____ Date _____

Pump Make: _____ Model _____ Serial No. _____

~~No Pump Req.~~ No Fields 1 Square Feet 1035 Linear Feet 345

No Lines 3 Trench Width 36" Max Trench Bottom Depth 36" Gravel Depth 12"

☑ New System ☐ Repair System Type: I (II) III, IV, V, VI

System Description: Conv. Gravity

Repair System Description: " "

Maintenance Agreement Required: ☐ Yes ☑ No

☑ House/Mod. Home ☑ Mobile Home ☐ Business ☐ Other

No. Bedrooms 3 No. Bathrooms 2 No. Employees _____

☐ Slab ☐ Crawl Space ☐ Basement w/plumbing ☐ Basement wo/plumbing


Water Supply: ☑ Individual ☐ Community ☐ Public

Comments:

mobile Home located 100' off Rt + In center of 315' road Frontage

Comments:

INITIAL SITE SKETCH

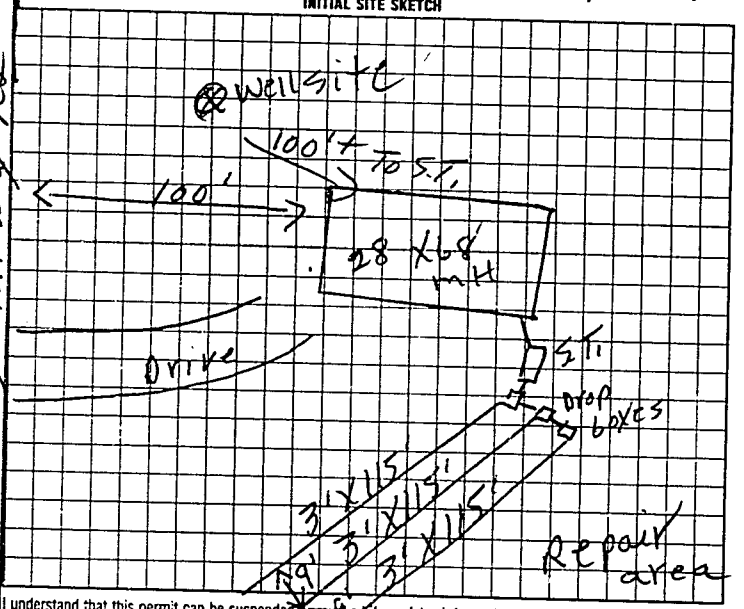

AS BUILT SKETCH

Same as initial sketch

I understand that this permit can be suspended or revoked if any false information is supplied toward securing the permit/any unauthorized changes are made to the site/any unauthorized changes are made in the installation of the system. Improvement Permit is valid for 60 months from date of issuance.

Signed: X Russell Wilson

Improvement Permit by: R. C. Moore date 9-5-97

Existing System Inspection by: Authorization to Cont. R. C. Moore date 9-5-97

Installed by: A-1 Backhoe

Certificate of Completion by: _____ date _____

Operation Permit by: R. C. Moore date 9-17-97

HEALTH DEPT COPY WHITE INSPECTION COPY (FINAL) GREEN OWNER COPY (FINAL) YELLOW INSPECTION COPY (INITIAL) PINK OWNER COPY (INITIAL) GOLD

7281

Authorization to Cont. EXPIRES 60 MOS FROM ISSUE

98 5000