IREDELL COUNTY HEALTH DEPARTMENT

STATESVILLE 704-878-5305 MOORESVILLE 704-664-5281

IMPROVEMENT PERMIT / AUTHORIZATION TO CONSTRUCT / OPERATION PERMIT / EXISTING SYSTEM INSPECTION

PERMIT# 072270 PIN# 4884 30 5885

OWNER OR CONTRACTOR HERMAN S. HARRIS PHONE: Business DATE 3-19-98

ADDRESS 3133 HARMONY HIGHWAY, HARMONY, NC 28634 Home 546-5564

LOCATION US 21 N, TR ANTHONY ROAD, 1 ON LEFT PAST BOX #221

SUBDIVISION BLOCK / SECTION LOT LOT AREA 3.16 ACRES SITE CLASS PS DESIGN FLOW 480 L.T.A.R. 0.40 GPD/FT²

Septic Tank: 1000 Gallons; STB 1012 Date 4-20-98

Pump Tank: Gallons; PT Date

Pump Make: Model Serial No.

Nitrification Field: No Fields 1 Square Feet 1200 Linear Feet 400

No Lines FOUR Trench Width 36" Max Trench Bottom Depth 36" Gravel Depth 12"

☑ New System ☐ Repair System Type: (I) II, III, IV, V, VI

System Description: CONVENTIONAL, GRAVITY

Repair System Description: CONV. GRAVITY

Maintenance Agreement Required: ☐ Yes ☑ No

☐ House/Mod. Home ☑ Mobile Home ☐ Business ☐ Other

No. Bedrooms 4 No. Bathrooms 2½ No. Employees


☐ Slab ☑ Crawl Space ☐ Basement w/plumbing ☐ Basement wo/plumbing

Water Supply: ☑ Individual ☐ Public ☐ Community NEIGHBORING WELL


Comments:/Conditions:

Comments:/Conditions:

INITIAL SITE SKETCH ~ SCALE 1" = 50'

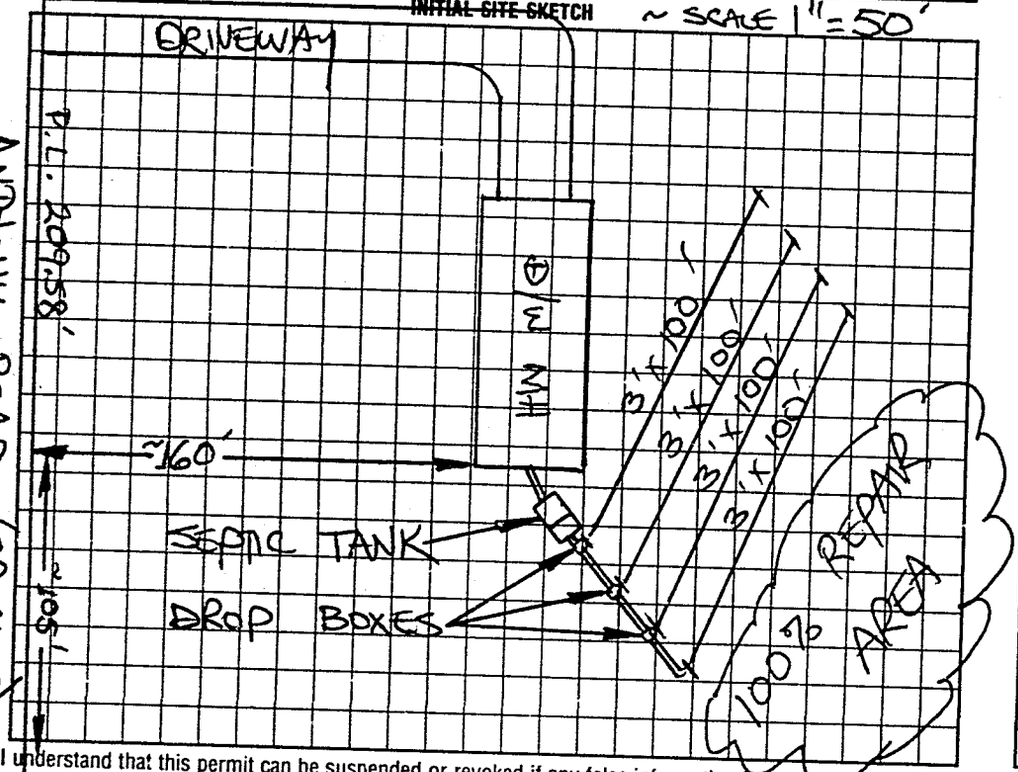

AS BUILT SKETCH

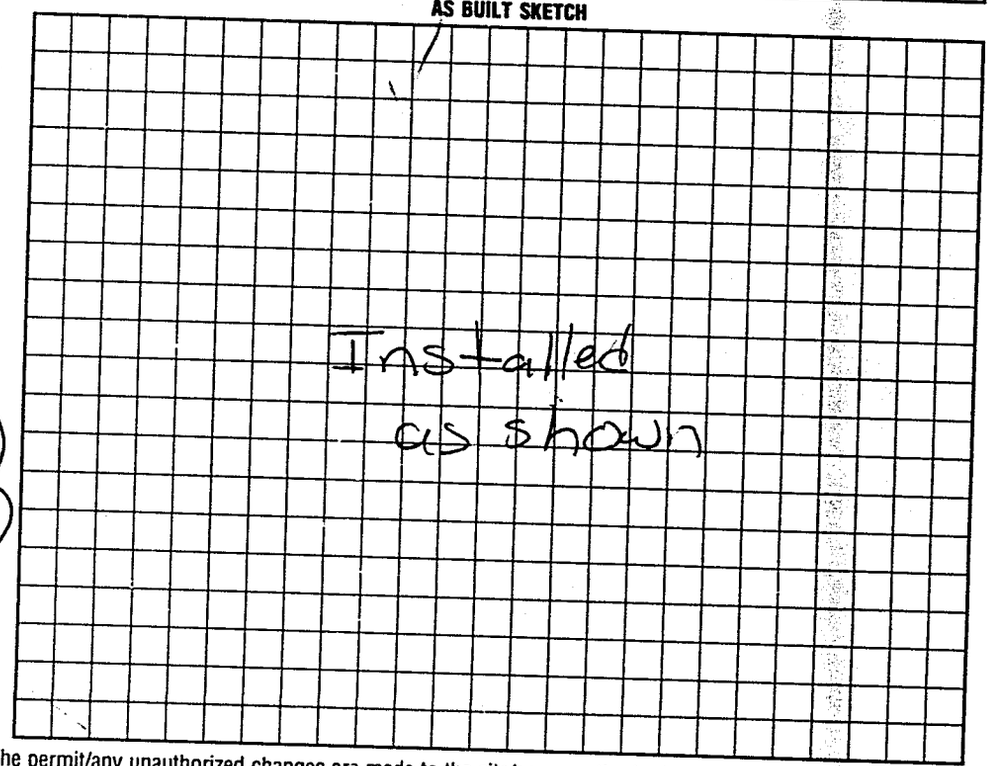

I understand that this permit can be suspended or revoked if any false information is supplied toward securing the permit/any unauthorized changes are made to the site/any unauthorized changes are made in the installation of the system. Improvement Permit with plat valid without expiration. Improvement Permit with site plan valid for sixty months. Authorization to Construct is valid for a period equal to that of Improvement Permit – not to exceed sixty months.

Signed: + Scott Harris date

Improvement Permit by: STEVE HEDRICK date 3-19-98

Authorization to Construct by: STEVE HEDRICK date 3-19-98

Installed by: A-1 Backhoe

Operation Permit by: Mat C Orf date 6-25-98

Existing System Inspection by: date

HEALTH DEPT. COPY: WHITE INSPECTION COPY (FINAL): GREEN OWNER COPY (FINAL): YELLOW INSPECTION COPY (INITIAL): PINK OWNER COPY (INITIAL): GOLD