IREDELL COUNTY HEALTH DEPARTMENT

STATESVILLE 704-878-5305 MOORESVILLE 704-664-5281

IMPROVEMENT PERMIT / AUTHORIZATION TO CONSTRUCT / OPERATION PERMIT / EXISTING SYSTEM INSPECTION

PERMIT# REPAIR PIN# DATE 2-2-00

OWNER OR CONTRACTOR ALBERT HARRIS PHONE: Business Home 546-7748

ADDRESS 209 ANTHONY ROAD, HARMONY, NC 28634

LOCATION US 21 NORTH, TR ANTHONY ROAD, 0.5 MILE ON LEFT AT BOX # 209

SUBDIVISION BLOCK / SECTION LOT LOT AREA AMPLE SITE CLASS PS DESIGN FLOW 360 L.T.A.R. EXISTING

Septic Tank: EXISTING Gallons: STB Date

Pump Tank: Gallons: PT Date

Pump Make: Model Serial No.

Nitrification Field: No Fields 1 Square Feet 450 Linear Feet 150

No Lines ONE Trench Width 36" Max Trench Bottom Depth 36" Gravel Depth 12"

☐ New System ☑ Repair System Type: I (II) III. IV. V. VI

System Description: CONVENTIONAL GRAVITY

Repair System Description: CONV. GRAVITY

Maintenance Agreement Required: ☐ Yes ☑ No

☑ House/Mod. Home ☐ Mobile Home ☐ Business ☐ Other

No. Bedrooms 3 No. Bathrooms 1 No. Employees

☐ Slab ☑ Crawl Space ☐ Basement w/plumbing ☑ Basement wo/plumbing


Water Supply: ☑ Individual ☐ Public ☐ Community

WELL


Comments:/Conditions: ① TIE ALL PLUMBING INTO SEPTIC TANK ② INSTALL NEW 3'x 150' LINE AS SHOWN ON CONTOUR ③ THIS PERMIT SERVES AS NOTICE OF VIOLATION - TO BE REPAIRED BY 3-15-00

Comments:/Conditions: DRAINLINE INSTALLED AS SHOWN DUE TO ROCK IN LOCATION INITIALLY PROPOSED — WITH PRIOR HEALTH DEPARTMENT APPROVAL

INITIAL SITE SKETCH

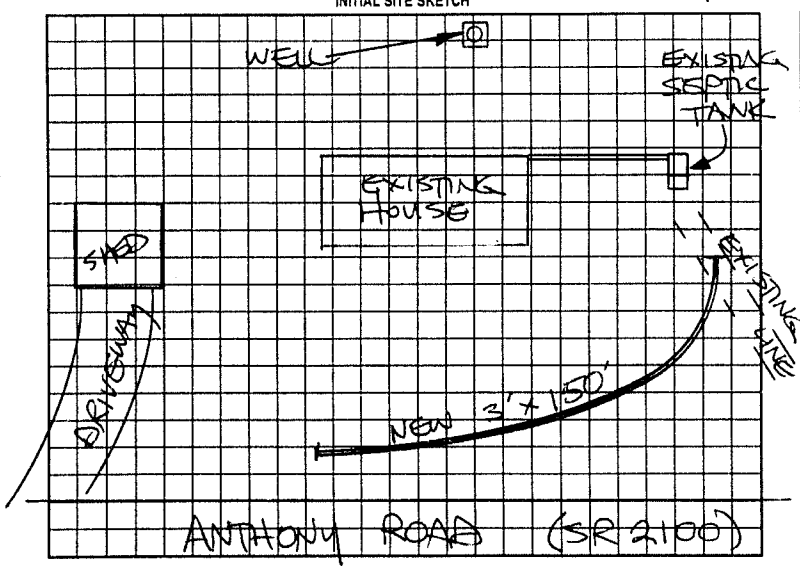

AS BUILT SKETCH

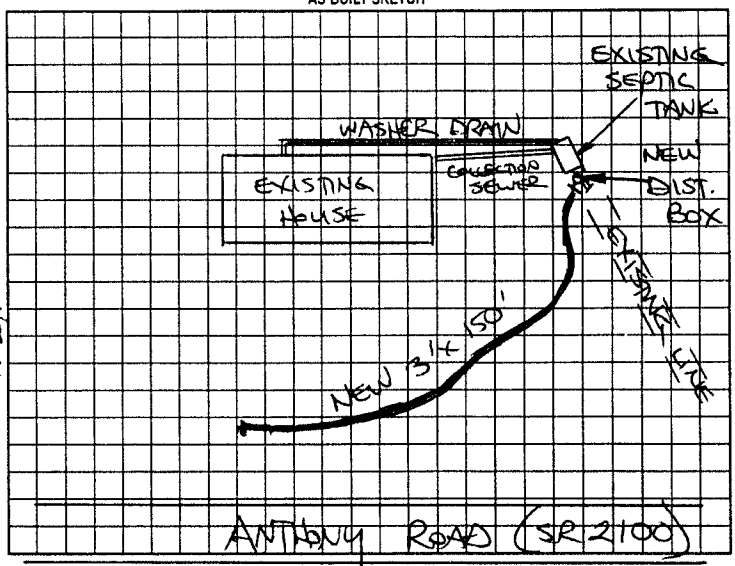

Permit can be suspended or revoked if any false information is supplied toward securing the permit/any unauthorized changes are made to the site/any unauthorized changes are made in the installation of the system. Improvement Permit with plat valid without expiration. Improvement Permit with site plan valid for sixty months. Authorization to Construct is valid for a period equal to that of Improvement Permit – not to exceed sixty months.

Signed: Albert Harris date 1-2-00 Installed by: A-1 BACKHOE

Improvement Permit by: STEVE HEDRICK date 2-2-00 Operation Permit by: STEVE HEDRICK date 2-25-00

Authorization to Construct by: STEVE HEDRICK date 2-2-00 Existing System Inspection by: date

HEALTH DEPT. COPY: WHITE OWNER COPY (FINAL): YELLOW OWNER COPY (INITIAL): PINK