IREDELL COUNTY HEALTH DEPARTMENT

STATESVILLE 704-878-5305 MOORESVILLE 704-664-5281

IMPROVEMENT PERMIT / AUTHORIZATION TO CONSTRUCT / OPERATION PERMIT / EXISTING SYSTEM INSPECTION

PERMIT# 070763 PIN# 4890 00 7075 DATE 12-18-97

OWNER OR CONTRACTOR RICKY DALE WOOD PHONE: Business 876-2542 Home 546-7937

ADDRESS 137 ROSWELL ROAD, HARMONY, NC 28634

LOCATION US 21N, TR NC901, TL GUILFORD ROAD, TL FOX HUNTER, 0.5 MILE on LEFT AT BOX #225

SUBDIVISION _____ BLOCK / SECTION _____ LOT _____ LOT AREA 35.98 ACRES SITE CLASS. PS1 DESIGN FLOW 240 L.T.A.R. 0.30 GPD/FT2

Septic Tank: 1000 Gallons; STB 928 Date 11-3-97

Pump Tank: _____ Gallons; PT _____ Date _____

Pump Make: _____ Model _____ Serial No. _____

Nitrification Field: No Fields 1 Square Feet 810 Linear Feet 270

No Lines THREE Trench Width 36" Max Trench Bottom Depth 36" Gravel Depth 12"

☑ New System ☐ Repair System Type: I, II, III, IV, V, VI

System Description: CONVENTIONAL GRAVITY

Repair System Description: CONV. PUMP.

Maintenance Agreement Required: ☐ Yes ☑ No

☐ House/Mod. Home ☑ Mobile Home ☐ Business ☐ Other

No. Bedrooms 2 No. Bathrooms 2 No. Employees ____


☐ Slab ☑ Crawl Space ☐ Basement w/plumbing ☐ Basement wo/plumbing

Water Supply: ☑ Individual ☐ Public ☐ Community WELL NEXT DOOR

Comments:/Conditions:

Comments:/Conditions:

INITIAL SITE SKETCH SCALE: 1" = 40'

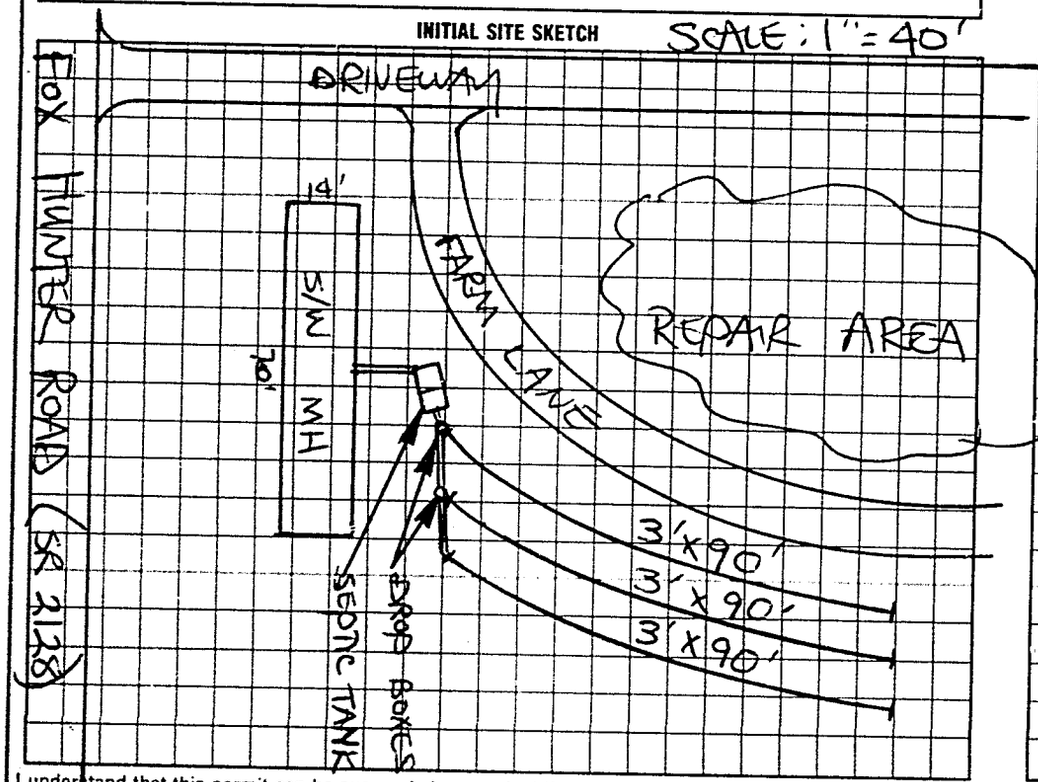

AS BUILT SKETCH

SYSTEM INSTALLED ACCORDING TO INITAL SITE SKETCH

I understand that this permit can be suspended or revoked if any false information is supplied toward securing the permit/any unauthorized changes are made to the site/any unauthorized changes are made in the installation of the system. Improvement Permit with plat valid without expiration. Improvement Permit with site plan valid for sixty months. Authorization to Construct is valid for a period equal to that of Improvement Permit – not to exceed sixty months.

Signed: Lisa Link date 12-18-97

Improvement Permit by: STEVE HEDRICK date 12-18-97

Authorization to Construct by: STEVE HEDRICK date 12-18-97

Installed by: SAMMY REALS

Operation Permit by: STEVE HEDRICK date 2-2-98

Existing System Inspection by: _____ date _____

HEALTH DEPT COPY: WHITE INSPECTION COPY (FINAL): GREEN OWNER COPY (FINAL): YELLOW INSPECTION COPY (INITIAL): PINK OWNER COPY (INITIAL): GOLD