IREDELL COUNTY HEALTH DEPARTMENT

STATESVILLE 704-878-5305 MOORESVILLE 704-664-5281

IMPROVEMENT PERMIT / AUTHORIZATION TO CONSTRUCT / OPERATION PERMIT / EXISTING SYSTEM INSPECTION

PERMIT# 072480 PIN# 4880 86 8477

OWNER OR CONTRACTOR TYSON FOODS DATE 6-12-98

ADDRESS P.O. BOX 158, HARMONY, NC 28634 PHONE: Business 546-2602 Home

LOCATION US 21 N, TR NC 901, TL SHEFFIELD ROAD, ON RIGHT AT DUTCHMAN CREEK

SUBDIVISION BLOCK / SECTION LOT LOT AREA 202.7 ACRES SITE CLASS. PS DESIGN FLOW 100 L.T.A.R. 0.8 GPD/FT²

Septic Tank: 1000 Gallons; STB 854 Date 5-19-98

Pump Tank: Gallons; PT Date

Pump Make: Model Serial No.

Nitrification Field: No Fields 1 Square Feet 150 Linear Feet 50

No Lines ONE Trench Width 36" Max Trench Bottom Depth 36" Gravel Depth 12"

☑ New System ☐ Repair System Type: I, II, III, IV, V, VI

System Description: CONVENTIONAL GRAVITY

Repair System Description: CONV. GRAVITY

Maintenance Agreement Required: ☐ Yes ☑ No

☐ House/Mod. Home ☐ Mobile Home ☑ Business ☐ Other

No. Bedrooms No. Bathrooms No. Employees 3


☑ Slab ☐ Crawl Space ☐ Basement w/plumbing ☐ Basement wo/plumbing

Water Supply: ☑ Individual ☐ Public ☐ Community WELL

Comments:/Conditions: ① INSTALL SYSTEM AS FLAGGED ON SITE ② ERECT BARRIER TO PREVENT VEHICULAR TRAFFIC OVER SYSTEM

Comments:/Conditions:

INITIAL SITE SKETCH SCALE: 1" = 40'

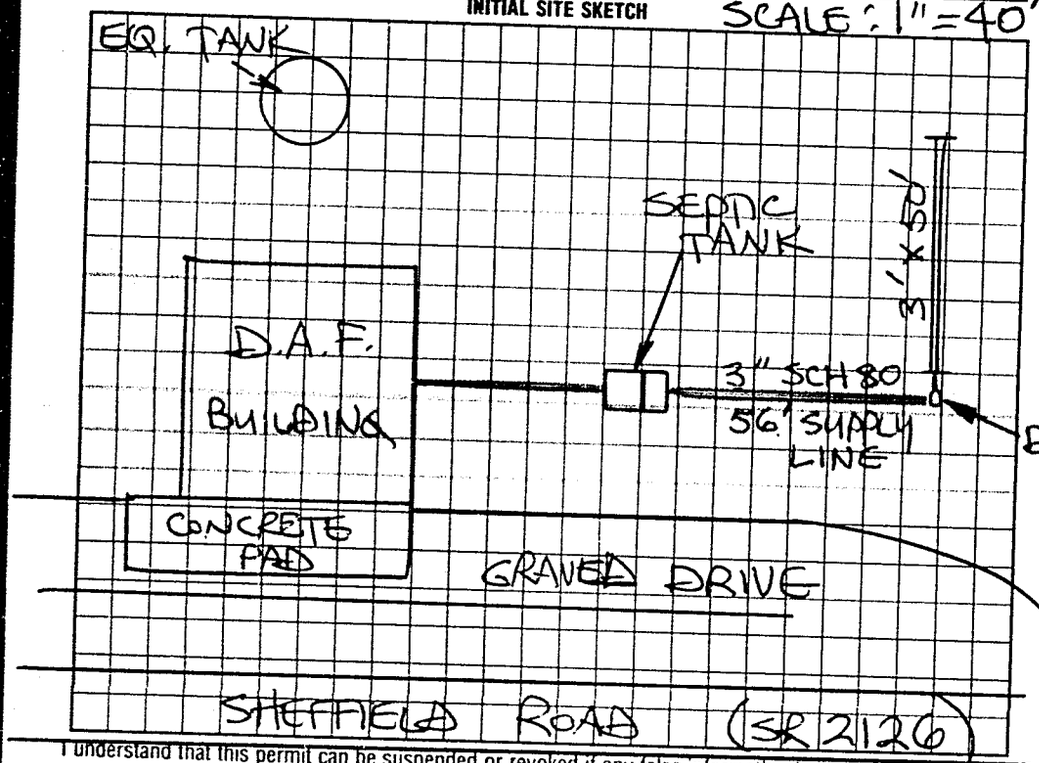

AS BUILT SKETCH

SYSTEM INSTALLED ACCORDING TO INITIAL SITE SKETCH

I understand that this permit can be suspended or revoked if any false information is supplied toward securing the permit/any unauthorized changes are made to the site/any unauthorized changes are made in the installation of the system. Improvement Permit with plat valid without expiration. Improvement Permit with site plan valid for sixty months. Authorization to Construct is valid for a period equal to that of Improvement Permit – not to exceed sixty months.

Signed: Mark Johnson

Improvement Permit by: STEVE HEDRICK date 6-12-98

Authorization to Construct by: STEVE HEDRICK date 6-12-98

Installed by: C & V UTILITIES

Operation Permit by: STEVE HEDRICK date 7-17-98

Existing System Inspection by: date

HEALTH DEPT COPY WHITE INSPECTION COPY (FINAL) GREEN OWNER COPY (FINAL) YELLOW INSPECTION COPY (INITIAL) PINK OWNER COPY (INITIAL) GOLD