IREDELL COUNTY HEALTH DEPARTMENT

Statesville Phone TR 3-7271 Mooresville Phone NO 3-1271

PERMIT TO INSTALL SEPTIC TANK

Permit No. 57 Permit Date 7-8 19 71

Owner VETERANS GREASE & TALLOW Co Address HARMONY, N.C.

Installed By LACKEY BROS. Address STONY POINT, N.C.


Location of Property HARMONY - 901 E to Rd #2126 TURN LEFT - ON LEFT PAST CREEK.

Tank		Capacity		Length of Lines		Fixtures	
Block	( )	1000	(✓)	225'	(✓)	No. of Baths	(✓)
Precast	(✓)	1250	( )	250'	( )	Dishwasher	( )
		1500	( )	Other		Garbage Grdr.	( )
		Other				Other	

NOTIFY HEALTH DEPARTMENT AT LEAST EIGHT HOURS BEFORE TANK IS TO BE INSPECTED.

Final Inspection 7-8 19 71 Approved (✓) Disapproved ( )

Remarks

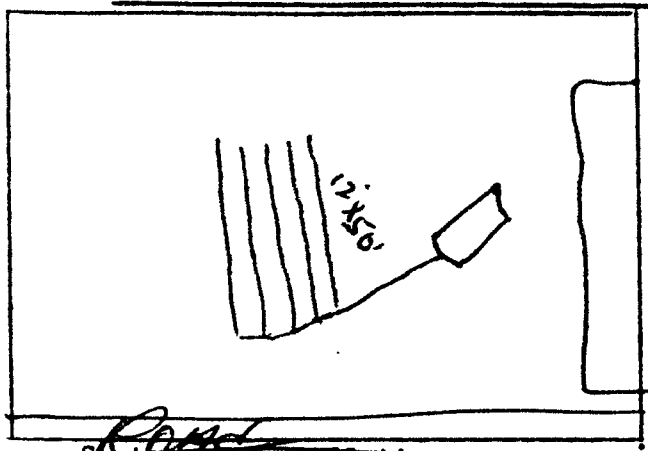

This system is for Shop only -

Sketch of Installation

Sanitarian