IREDELL COUNTY HEALTH DEPARTMENT

STATESVILLE 704-878-5305 MOORESVILLE 704-664-5281

IMPROVEMENT PERMIT / AUTHORIZATION TO CONSTRUCT / OPERATION PERMIT / EXISTING SYSTEM INSPECTION

PERMIT# 102886 PIN# 4890-06-8207 DATE 10-24-01

OWNER OR CONTRACTOR Holly FARMS PHONE: Business (704) 546-2602 Home

ADDRESS 501 SHEFFIELD ROAD HARMONY NC 28634

LOCATION US 21 N, TR NC901, JL SHEFFIELD ROAD, AT HUNTING CREEK ON RIGHT

SUBDIVISION BLOCK / SECTION LOT LOT AREA ACREAGE SITE CLASS PS DESIGN FLOW LIMITED L.T.A.R. EXISTING

Septic Tank: 1500 Gallons: STB 619 Date 8-23-73
Pump Tank: Gallons: PT Date
Pump Make: Model Serial No
Nitrification Field: No Fields 1 Square Feet 900 Linear Feet 300
No Lines SIX Trench Width 36" Max Trench Bottom Depth 36" Gravel Depth 24"

☐ New System ☐ Repair System Type: I II III IV V VI
System Description: CONVENTIONAL GRAVITY
Repair System Description:
Maintenance Agreement Required: ☐ Yes ☑ No
☐ Slab ☐ Crawl Space ☑ Basement w/plumbing ☐ Basement wo/plumbing

☐ House/Mod. Home No. Bedrooms
☐ Mobile Home No. Bathrooms
☑ Business ~ No. Employees 35
☐ Other


Water Supply: ☐ Individual ☑ Public ☐ Community

Comments/Conditions:

Comments/Conditions: NO ADDITIONAL INCREASE IN EMPLOYEES INDICATED. ORIGINAL SYSTEM PERMITED AS A REPAIR. SYSTEM FUNCTIONING PROPERLY AT TIME OF INSPECTION

INITIAL SITE SKETCH

AS BUILT SKETCH

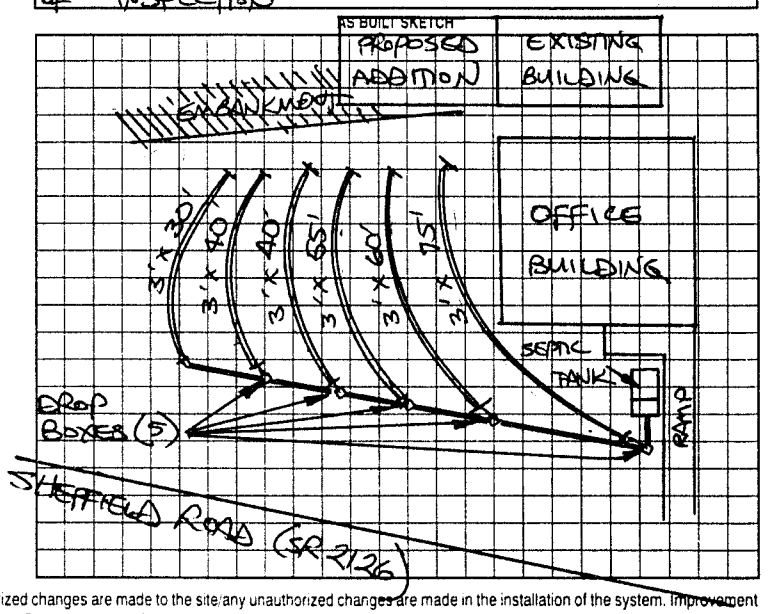

Permit can be suspended or revoked if any false information is supplied toward securing the permit/any unauthorized changes are made to the site/any unauthorized changes are made in the installation of the system. Improvement Permit with plat valid without expiration. Improvement Permit with site plan valid for sixty months. Authorization to Construct is valid for a period equal to that of Improvement Permit – not to exceed sixty months.

Signed: date Installed by:

Improvement Permit by: date Operation Permit by: date

Authorization to Construct by: date Existing System Inspection by: STEVE HEDRICK date 10-24-01

HEALTH DEPT. COPY WHITE OWNER COPY (FINAL) YELLOW OWNER COPY (INITIAL) PINK