IREDELL COUNTY HEALTH DEPARTMENT

STATESVILLE 704-878-5305 MOORESVILLE 704-664-5281

IMPROVEMENT PERMIT / AUTHORIZATION TO CONSTRUCT / OPERATION PERMIT / EXISTING SYSTEM INSPECTION

PERMIT# 075090 PIN# 4890 10 3814 DATE 7-24-98

OWNER OR CONTRACTOR DAVID SMUTZ PHONE: Business Home 878-2336

ADDRESS 175 BUTTERFIELD LOOP, STATESVILLE, NC 28625

LOCATION US 21 N, TR NC 901, TL GUILFORD ROAD, TL FOX HUNTER ROAD, 0.7 MILE ON LEFT

SUBDIVISION ~~GRAY FOX RIDGE~~ BLOCK / SECTION LOT 16 LOT AREA 8.363 ACRES SITE CLASS. PS DESIGN FLOW 360 L.T.A.R. 0.30 GPD/FT²

Septic Tank: 1000 Gallons; STB 1012 Date 11-16-98

Pump Tank: Gallons; PT Date

Pump Make: Model Serial No.

Nitrification Field: No Fields 1 Square Feet 1200 Linear Feet 400

No Lines FOUR Trench Width 36" Max Trench Bottom Depth 36" Gravel Depth 12"

☑ New System ☐ Repair System Type: I, II, III, IV, V, VI

System Description: CONVENTIONAL GRAVITY

Repair System Description: CONV. GRAVITY

Maintenance Agreement Required: ☐ Yes ☑ No

☑ House/Mod. Home No. Bedrooms 3

☐ Mobile Home No. Bathrooms 2

☐ Business No. Employees

☐ Other FUTURE 3 BR


☐ Slab ☑ Crawl Space ☐ Basement w/plumbing ☐ Basement wo/plumbing

Water Supply: ☑ Individual ☐ Public ☐ Community

Comments:/Conditions: KEEP SYSTEM MINIMUM 100' FROM WELL SITE.

Comments:/Conditions:

SCALE: 1" = 50' **INITIAL SITE SKETCH**

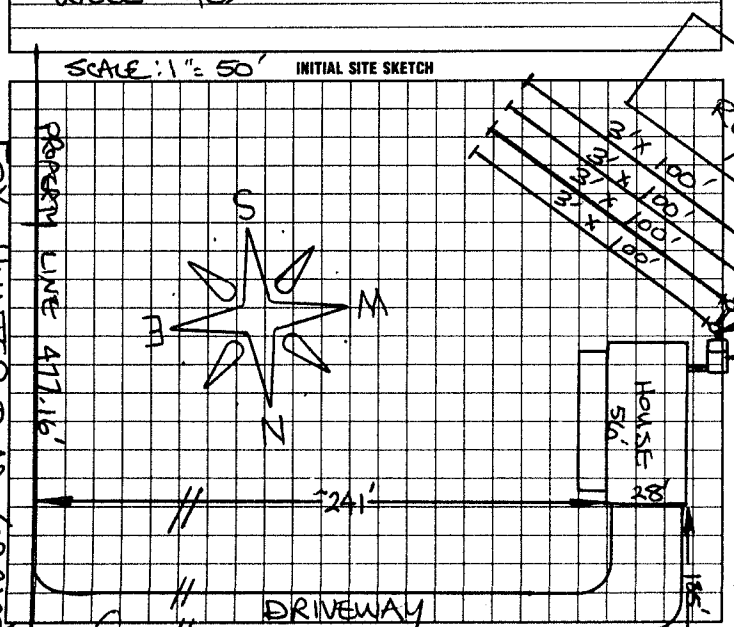

AS BUILT SKETCH

I understand that this permit can be suspended or revoked if any false information is supplied toward securing the permit/any unauthorized changes are made to the site/any unauthorized changes are made in the installation of the system. Improvement Permit with plat valid without expiration. Improvement Permit with site plan valid for sixty months. Authorization to Construct is valid for a period equal to that of Improvement Permit – not to exceed sixty months.

Signed: [signature] date 7-24-98 Installed by: Tommy Frye

Improvement Permit by: STEVE HEDRICK date 7-24-98 Operation Permit by: [signature] date 3-1-99

Authorization to Construct by: STEVE HEDRICK date 7-24-98 Existing System Inspection by: date

HEALTH DEPT. COPY: WHITE INSPECTION COPY (FINAL): GREEN OWNER COPY (FINAL) YELLOW INSPECTION COPY (INITIAL) PINK OWNER COPY (INITIAL): GOLD