IREDELL COUNTY HEALTH DEPARTMENT

STATESVILLE 704-878-5305 MOORESVILLE 704-664-5281

IMPROVEMENT PERMIT / AUTHORIZATION TO CONSTRUCT / OPERATION PERMIT / EXISTING SYSTEM INSPECTION

PERMIT# 09210 PIN# 4890 12 1936 DATE 10-2-00

OWNER OR CONTRACTOR PATRICIA LADD PHONE: Business Home 546-2172

ADDRESS 496 FOX HUNTER ROAD, HARMONY, NC 28634

LOCATION US 21 N, TR NC 901, TL ~~SYSON~~, TR FOX HUNTER RD, 1ST MH ON RIGHT

SUBDIVISION BLOCK / SECTION LOT LOT AREA 74 ACRES SITE CLASS PS DESIGN FLOW 240 L.T.A.R. EXISTING

Septic Tank: ~~EXISTING~~ Gallons; STB Date

Pump Tank: Gallons; PT Date

Pump Make: Model Serial No.

Nitrification Field: No Fields Square Feet Linear Feet ~~EXISTING~~

No Lines Trench Width Max Trench Bottom Depth Gravel Depth

☐ New System ☐ Repair System Type: I, II, III, V, VI

System Description: CONV, GRAVITY

Repair System Description:

Maintenance Agreement Required: ☐ Yes ☑ No

☐ House/Mod. Home No. Bedrooms 2

☑ Mobile Home No. Bathrooms 2

☐ Business No. Employees

☐ Other


☐ Slab ☑ Crawl Space ☐ Basement w/plumbing ☐ Basement wo/plumbing

Water Supply: ☐ Individual ☐ Public ☐ Community


Comments/Conditions:

Comments/Conditions:

INITIAL SITE SKETCH

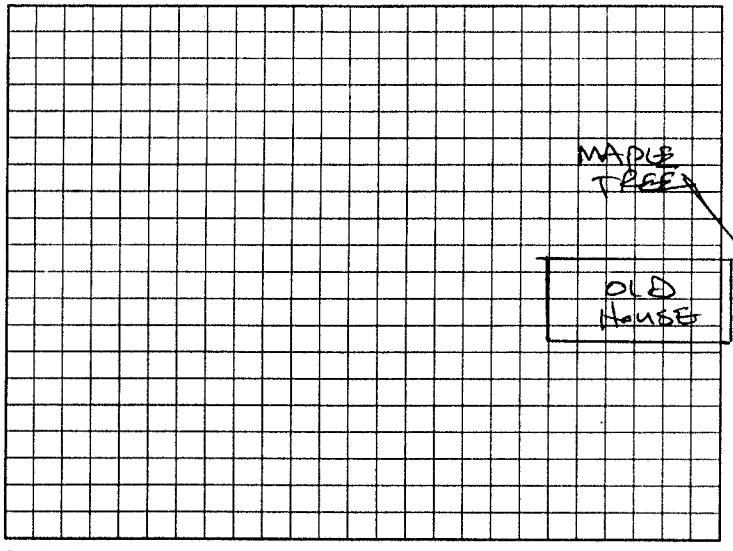

AS BUILT SKETCH BEO

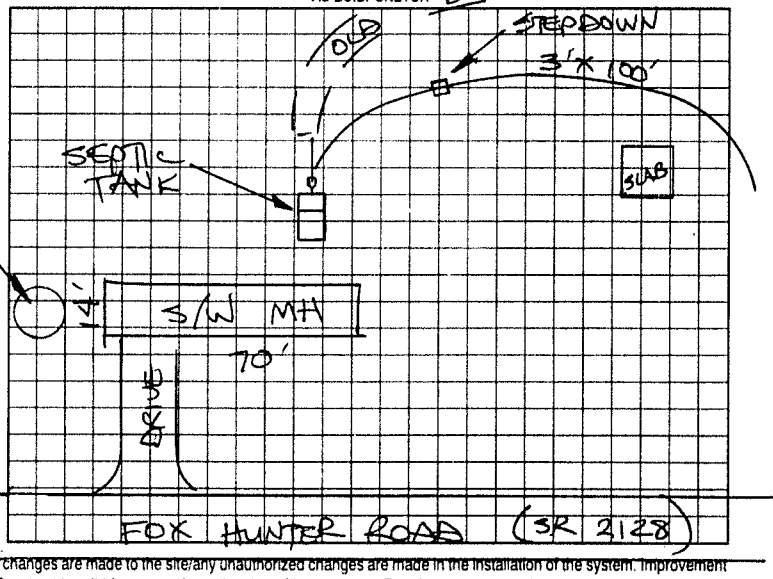

Permit can be suspended or revoked if any false information is supplied toward securing the permit/any unauthorized changes are made to the site/any unauthorized changes are made in the installation of the system. Improvement Permit with plat valid without expiration. Improvement Permit with site plan valid for sixty months. Authorization to Construct is valid for a period equal to that of Improvement Permit – not to exceed sixty months.

Signed: date Installed by:

Improvement Permit by: date Operation Permit by: date

Authorization to Construct by: date Existing System Inspection by: STEVE HEDRICK date 10-2-00

HEALTH DEPT COPY WHITE OWNER COPY (FINAL) YELLOW OWNER COPY (INITIAL) PINK