IREDELL COUNTY HEALTH DEPARTMENT

STATESVILLE 704-878-5305 MOORESVILLE 704-664-5281

IMPROVEMENT PERMIT / AUTHORIZATION TO CONSTRUCT / OPERATION PERMIT / EXISTING SYSTEM INSPECTION

PERMIT# Repair PIN# 4896-14-5065 DATE 11-24-08

OWNER OR APPLICANT Kenneth Ladd PHONE: Business Home

ADDRESS 496 Fox Hunter Road Harmony 28634

LOCATION 21N (R) 901 (L) Gulfad (L) Fox Hunter end at Fox Hunter 496

SUBDIVISION BLOCK / SECTION LOT LOT AREA 1.74 SITE CLASS. PS DESIGN FLOW 360 L.T.A.R. 125

Septic Tank: Exist Gallons: STB Exist Date Exist

Pump Tank: Gallons: PT Date

Pump Make: Model Serial No.

Nitrification Field: No Fields Square Feet Linear Feet 200

No Lines 2 Trench Width 36" Max Trench Bottom Depth 36" Gravel Depth

☐ New System ☑ Repair ☐ Expansion System Type: I (II) III IV V VI

System Description: 25% Gravity

Repair System Description:

Maintenance Agreement Required: ☐ Yes ☑ No

☑ House/Mod. Home No. Bedrooms 3

☐ Mobile Home No. Persons

☐ Business No. Employees

☐ Other

Water Supply: ☑ Individual ☐ Public ☐ Community

☑ Gravity ☐ Pressure ☐ Slab ☐ Crawl Space ☑ Basement w/plumbing ☐ Basement wo/plumbing

Comments:/Conditions: Install (2) 100' lines @ 25% reduction


Bottom line 41' from property line

Top line 84 feet from house

Comments:/Conditions:

Use existing distribution box if it is in good working order and can add another line

INITIAL SITE SKETCH

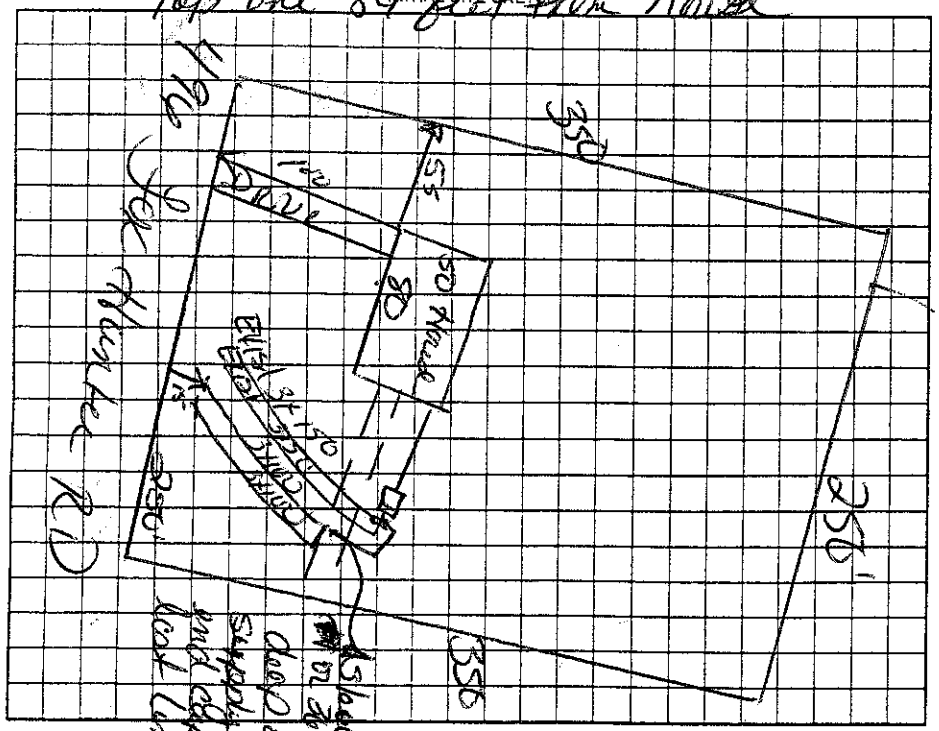

AS BUILT SKETCH

Permit can be suspended or revoked if any false information is supplied toward securing the permit/any unauthorized changes are made to the site/any unauthorized changes are made in the installation of the system. Improvement Permit with plat valid without expiration ☐ Improvement Permit with site plan valid for sixty months ☐ Authorization to Construct is valid for a period equal to that of Improvement Permit – not to exceed sixty months.

Signed Kenneth D Ladd date 11-24-08

Improvement Permit by: Kelly Cook date 11-24-08

Authorization to Construct by: Kelly Cook date 11-24-08

Installed by: David Young

Operation Permit by: Kelly Cook date 1-22-09

Existing System Inspection by: date

HEALTH DEPT. COPY: WHITE OWNER COPY (FINAL): YELLOW OWNER COPY (INITIAL): PINK