IREDELL COUNTY HEALTH DEPARTMENT

STATESVILLE 704-878-5305 MOORESVILLE 704-664-5281

IMPROVEMENT PERMIT / AUTHORIZATION TO CONSTRUCT / OPERATION PERMIT / EXISTING SYSTEM INSPECTION

PERMIT# 075265 PIN# 4890 18 5087

OWNER OR CONTRACTOR JOE DILLARD DATE 7-31-98

ADDRESS 554 SHEFFIELD ROAD, HARMONY NC 28634 PHONE: Business _____ Home 546-2089

LOCATION US 21 N, TR NC 901, TL SHEFFIELD ROAD, CROSS HUNTING CREEK 2ND MH ON RIGHT

SUBDIVISION JOE W. DILLARD BLOCK / SECTION _____ LOT _____ LOT AREA 9.0 ACRES SITE CLASS. PS DESIGN FLOW 240 L.T.A.R. 0.30 GPD/FT²

Septic Tank: 1000 Gallons; STB 760 Date 5-26-98
Pump Tank: _____ Gallons; PT _____ Date _____
Pump Make: _____ Model _____ Serial No. _____
Nitrification Field: No Fields 1 Square Feet 810 Linear Feet 270
No Lines THREE Trench Width 36" Max Trench Bottom Depth 30" Gravel Depth 12"

☑ New System ☐ Repair System Type: I, II, III, IV, V, VI
System Description: CONVENTIONAL GRAVITY
Repair System Description: CONV. GRAVITY
Maintenance Agreement Required: ☐ Yes ☑ No

☐ House/Mod. Home ☑ Mobile Home ☐ Business ☐ Other
No. Bedrooms 2 No. Bathrooms 2 No. Employees _____


☐ Slab ☑ Crawl Space ☐ Basement w/plumbing ☐ Basement wo/plumbing

Water Supply: ☐ Individual ☑ Public ☐ Community

Comments:/Conditions: ① CONSTRUCT SUBSURFACE INTERCEPT DRAINAGE DITCH AT LOCATION SHOWN BEGINNING 42" DEEP & OUT TO DAYLIGHT ② INSTALL THREE 3'x90' LINES ON CONTOUR, NO DEEPER THAN (30")

Comments:/Conditions:

INITIAL SITE SKETCH SCALE: 1" = 40'

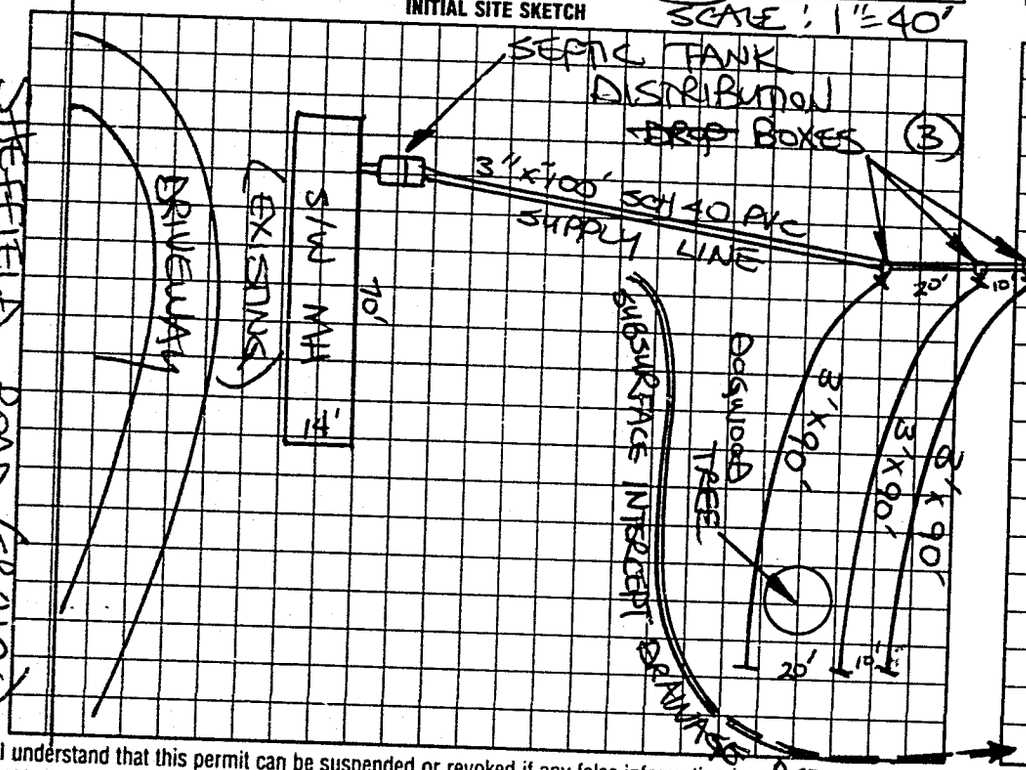

AS BUILT SKETCH

SYSTEM INSTALLED AS SHOWN ON INITIAL SITE SKETCH

I understand that this permit can be suspended or revoked if any false information is supplied toward securing the permit/any unauthorized changes are made to the site/any unauthorized changes are made in the installation of the system. Improvement Permit with plat valid without expiration. Improvement Permit with site plan valid for sixty months. Authorization to Construct is valid for a period equal to that of Improvement Permit – not to exceed sixty months.

Signed: Joe S Dillard date 8-3-98

Improvement Permit by: STEVE HEDRICK date 7-31-98

Authorization to Construct by: STEVE HEDRICK date 7-31-98

Installed by: DONALD LAKEY

Operation Permit by: STEVE HEDRICK date 8-25-98

Existing System Inspection by: _____ date _____

HEALTH DEPT. COPY: WHITE INSPECTION COPY (FINAL) GREEN OWNER COPY (FINAL): YELLOW INSPECTION COPY (INITIAL) PINK OWNER COPY (INITIAL): GOLD