63312

IREDELL COUNTY HEALTH DEPARTMENT

STATESVILLE 704-878-5305 MOORESVILLE 704-664-5281

IMPROVEMENT PERMIT / CERTIFICATE OF COMPLETION / OPERATION PERMIT / EXISTING SYSTEM INSPECTION

PROPERTY DESCRIPTION NO. 25056 DATE 9-25-96 TAX MAP NO. 17A-A-25 Watershed: ☐ Yes ☒ No

OWNER OR CONTRACTOR JAMES E. ADAMS PHONE: Business Home 634-2320

ADDRESS P.O. BOX 902 MOCKSVILLE NC 27028

LOCATION US 21 N, TR NC 901, TL SHEFFIELD RD, ~0.25 MILE ON RIGHT PAST HUNTING CREEK

SUBDIVISION BLOCK / SECTION LOT LOT AREA SITE CLASS. PS DESIGN FLOW 360 L.T.A.R. 0.40 GPD/FT²

Septic Tank: 1000 Gallons; STB 760 Date 8-14-96
Pump Tank: Gallons; PT Date
Pump Make: Model Serial No.
Nitrification Field: No Fields 1 Square Feet 900 Linear Feet 300
No Lines THREE Trench Width 36" Max Trench Bottom Depth 24 Gravel Depth 12"

☒ New System ☐ Repair System Type: I, II, III, IV, V, VI
System Description: CONVENTIONAL GRAVITY
Repair System Description: CONV. GRAVITY
Maintenance Agreement Required: ☐ Yes ☒ No
☐ Slab ☒ Crawl Space ☐ Basement w/plumbing ☐ Basement wo/plumbing


☒ House/Mod. Home No. Bedrooms 3
☒ Mobile Home No. Bathrooms 2
☐ Business No. Employees
☐ Other

Water Supply:
☒ Individual
☐ Community
☐ Public
WELL


Comments:

Comments:

INITIAL SITE SKETCH

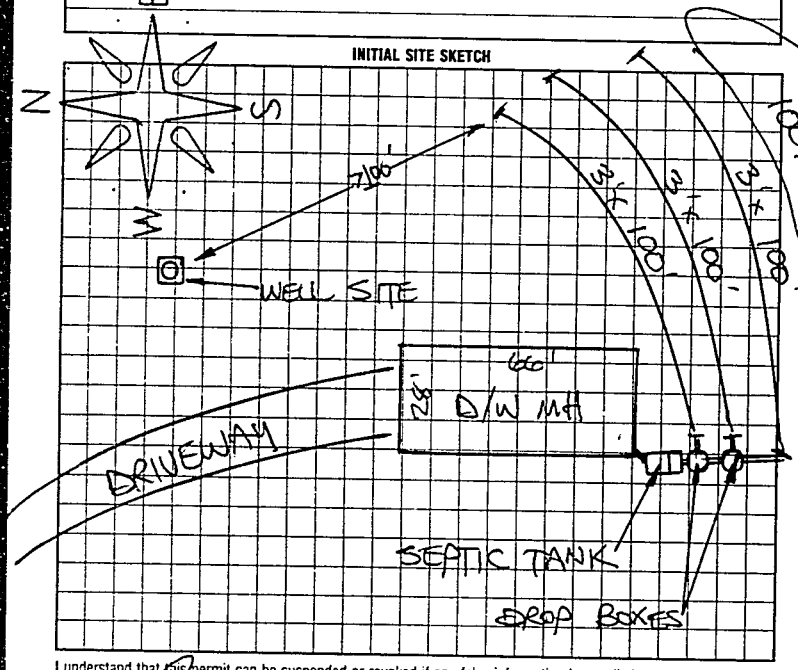

AS BUILT SKETCH

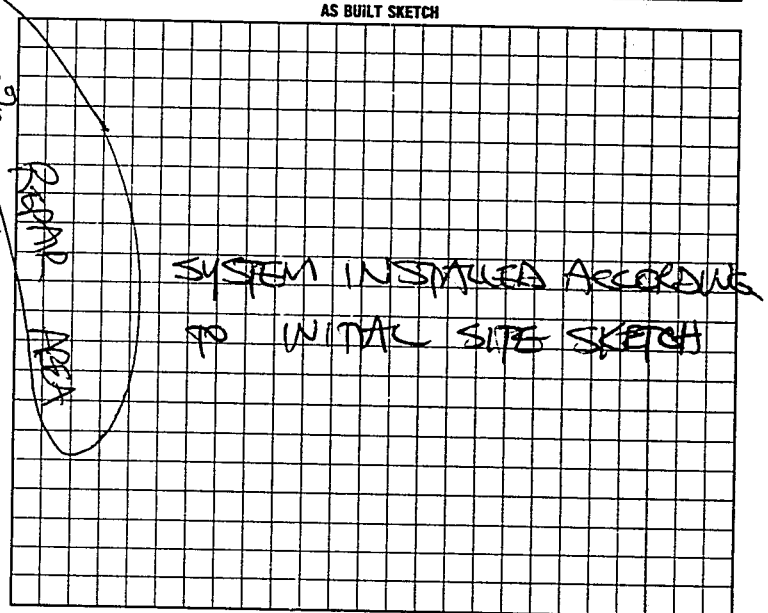

I understand that this permit can be suspended or revoked if any false information is supplied toward securing the permit/any unauthorized changes are made to the site/any unauthorized changes are made in the installation of the system.
AUTH. TO CONST IS VALID FOR A PERIOD EQUAL TO THE VALIDITY OF THE I.P. NOT TO EXCEED FIVE YEARS; I.P. W/ SITE PLAN IS VALID 5 YEARS

Signed: X James E Adams

Improvement Permit by: STEVE HEDRICK date 9-25-96

AUTHORIZATION TO CONSTRUCT

Existing System Inspection by: STEVE HEDRICK date 9-25-96

Installed by: RANDY MILLER (DAVIE CO)

Certificate of Completion by: date

Operation Permit by: STEVE HEDRICK date 10-24-96

HEALTH DEPT. COPY: WHITE INSPECTION COPY (FINAL): GREEN OWNER COPY (FINAL): YELLOW INSPECTION COPY (INITIAL): PINK OWNER COPY (INITIAL): GOLD