IREDELL COUNTY HEALTH DEPARTMENT

STATESVILLE 704-878-5305 MOORESVILLE 704-664-5281

IMPROVEMENT PERMIT / AUTHORIZATION TO CONSTRUCT / OPERATION PERMIT / EXISTING SYSTEM INSPECTION

PERMIT# 083227 PIN# 4890 18 5021 (PART OF) DATE 8-18-99

OWNER OR CONTRACTOR JOE WAYNE DILLARD PHONE: Business Home 546-2089

ADDRESS 568 SHEFFIELD ROAD, HARMONY, NC 28634

LOCATION US 21 NORTH, TR NC901, TL SHEFFIELD ROAD, ON RIGHT NEXT TO BOX #568

SUBDIVISION BLOCK / SECTION LOT LOT AREA 0.5 ACRE SITE CLASS PS DESIGN FLOW 240 L.T.A.R. 0.30 GPD/FT²

Septic Tank: 1000 Gallons; STB 760 Date 6-27-99

Pump Tank: Gallons; PT Date

Pump Make: Model Serial No.

Nitrification Field: No Fields 1 Square Feet 810 Linear Feet 270

No Lines FIVE Trench Width 36" Max Trench Bottom Depth 26" Gravel Depth 12"

☑ New System ☐ Repair System Type: I (II) III IV V VI

System Description: CONVENTIONAL GRAVITY

Repair System Description: CONV. GRAVITY

Maintenance Agreement Required: ☐ Yes ☑ No

☐ House/Mod. Home ☐ Mobile Home ☐ Business ☐ Other

No. Bedrooms 2 No. Bathrooms 2 No. Employees


☐ Slab ☑ Crawl Space ☐ Basement w/plumbing ☐ Basement wo/plumbing

Water Supply: ☐ Individual ☑ Public ☐ Community

Comments/Conditions

Comments/Conditions SEPTIC TANK W/ RISERS INSTALLED USING "ZABEL" FILTER

INITIAL SITE SKETCH SCALE 1" = 40'

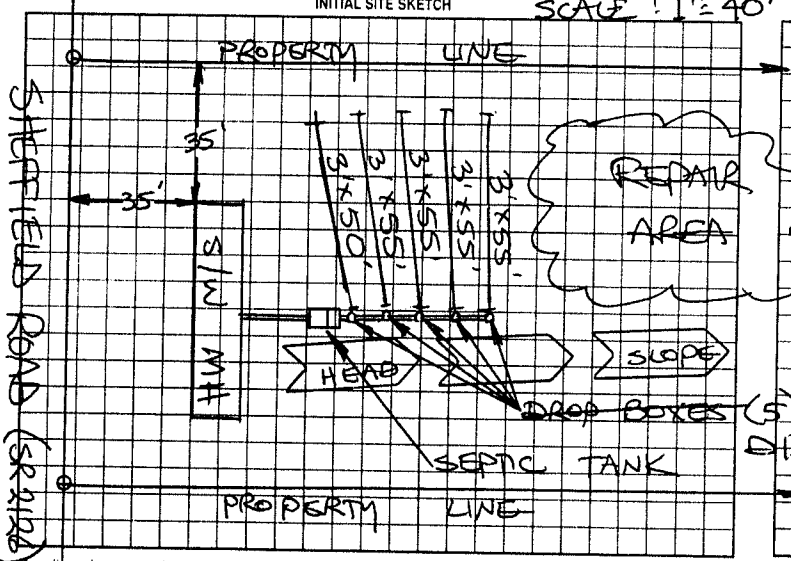

AS BUILT SKETCH

SYSTEM INSTALLED ACCORDING TO INITIAL SITE SKETCH

DISTRIBUTION BOXES W/ SPEED LEVELERS

Permit can be suspended or revoked if any false information is supplied toward securing the permit/any unauthorized changes are made to the site/any unauthorized changes are made in the installation of the system. Improvement Permit with plat valid without expiration. Improvement Permit with site plan valid for sixty months. Authorization to Construct is valid for a period equal to that of Improvement Permit – not to exceed sixty months.

Signed: Joe E Dillard date 8-23-99 Installed by: DONALD LAKEY

Improvement Permit by: STEVE HEDRICK date 8-18-99 Operation Permit by: STEVE HEDRICK date 9-13-99

Authorization to Construct by: STEVE HEDRICK date 8-18-99 Existing System Inspection by: date

HEALTH DEPT. COPY: WHITE OWNER COPY (FINAL): YELLOW OWNER COPY (INITIAL): PINK