IREDELL COUNTY HEALTH DEPARTMENT

STATESVILLE 704-878-5305 MOORESVILLE 704-664-5281

IMPROVEMENT PERMIT / AUTHORIZATION TO CONSTRUCT / OPERATION PERMIT / EXISTING SYSTEM INSPECTION

PERMIT# 086053 PIN# 4890 18 5021 (PART) DATE 2-23-00

OWNER OR CONTRACTOR JOE WAYNE DILLARD PHONE: Business Home 546-2089

ADDRESS 568 SHEFFIELD ROAD, HARMONY, NC 28634

LOCATION US 21N, TR NC 901, TL SHEFFIELD ROAD, ~ 2 MILES ON RIGHT

SUBDIVISION JOE WAYNE DILLARD BLOCK / SECTION LOT 3 LOT AREA 0.58Ac + SITE CLASS PS DESIGN FLOW 240 L.T.A.R. 0.20 GPD/FT²

Septic Tank: 1000 Gallons: STB 620 Date 1-25-00
Pump Tank: Gallons; PT Date
Pump Make: Model Serial No.
Nitrification Field: No Fields 1 Square Feet EQ. TO 1200 Linear Feet 200+
No Lines SIX Trench Width 24" Max Trench Bottom Depth 36"

☑ New System ☐ Repair System Type: I, II, III, IV, V, VI
System Description: PPBPS + GRAVITY
Repair System Description: LOW PRESSURE PIPE PBPS
Maintenance Agreement Required: ☐ Yes ☑ No
Gravel Depth SAND 6" ☐ Slab ☑ Crawl Space ☐ Basement w/plumbing ☐ Basement wo/plumbing


☐ House/Mod. Home No. Bedrooms 3
☐ Mobile Home No. Bathrooms 2
☐ Business No. Employees
☐ Other

Water Supply: ☐ Individual ☑ Public ☐ Community


Comments:/Conditions: INSTALL 50% REDUCTION SYSTEM USING FORTY-SIX (46) PPBPS PANELS IN LINES ON CONTOUR AS SHOWN. USE ONE FLOW DIVIDER TEE SPLITTING INTO TWO SERIES OF DROP BOXES.

Comments:/Conditions: SEPTIC TANK W/ RISERS INSTALLED USING "ZABEL" FILTER

INITIAL SITE SKETCH

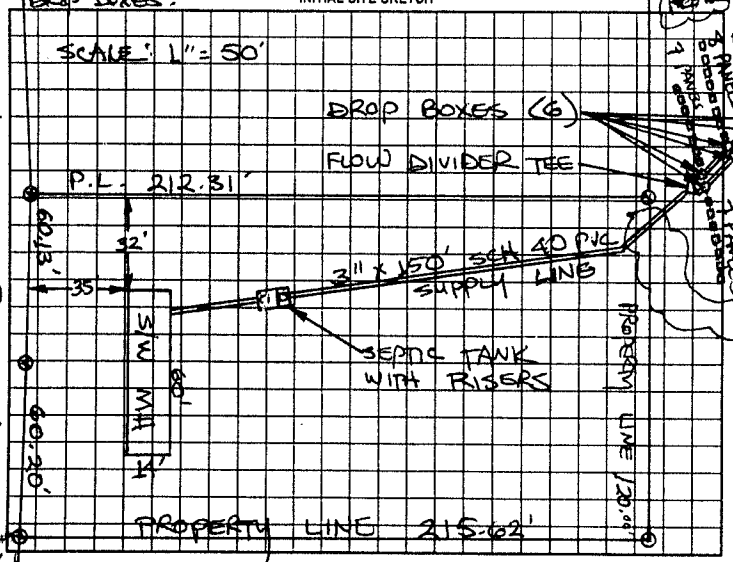

AS BUILT SKETCH

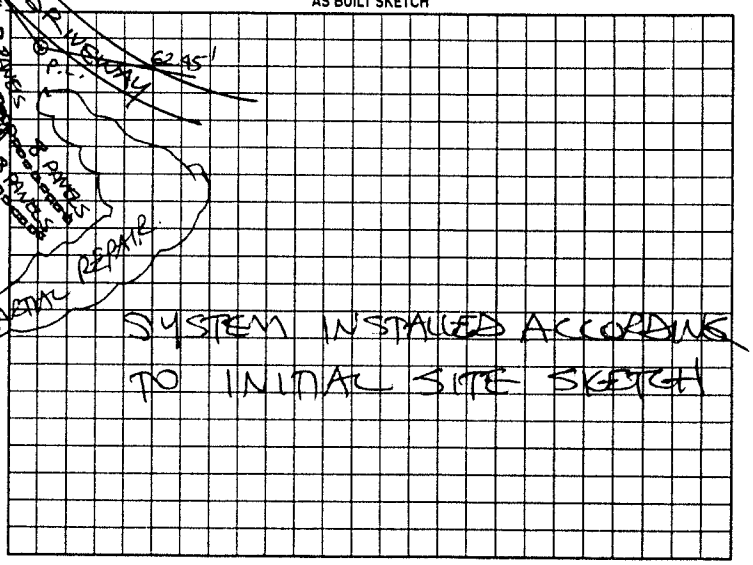

Permit can be suspended or revoked if any false information is supplied toward securing the permit/any unauthorized changes are made to the site/any unauthorized changes are made in the installation of the system. Improvement Permit with plat valid without expiration. Improvement Permit with site plan valid for sixty months. Authorization to Construct is valid for a period equal to that of Improvement Permit – not to exceed sixty months.

Signed: Joe W. Dillard date 2-24-00 Installed by: SAMMY REAVES

Improvement Permit by: STEVE HEDRICK date 2-23-00 Operation Permit by: STEVE HEDRICK date 3-31-00

Authorization to Construct by: STEVE HEDRICK date 2-23-00 Existing System Inspection by: date

HEALTH DEPT. COPY: WHITE OWNER COPY (FINAL): YELLOW OWNER COPY (INITIAL): PINK