IREDELL COUNTY HEALTH DEPARTMENT

STATESVILLE 704-878-5305 MOORESVILLE 704-664-5281

IMPROVEMENT PERMIT / AUTHORIZATION TO CONSTRUCT / OPERATION PERMIT / EXISTING SYSTEM INSPECTION

PERMIT# 075264 PIN# 4890 18 5087 DATE 7-31-98

OWNER OR CONTRACTOR JOE WAYNE DILLARD PHONE: Business _____ Home 546-2089

ADDRESS 554 SHEFFIELD ROAD, HARMONY NC 28634

LOCATION US 21 N, TR NC 901, TL SHEFFIELD RD, 1 CROSS HUNTING CREEK, 3RD MH ON RIGHT

SUBDIVISION JOE W. DILLARD BLOCK / SECTION _____ LOT 2 LOT AREA 26,000 SF± SITE CLASS. PS DESIGN FLOW 360 L.T.A.R. 0.33 GPD/FT²

Septic Tank: 1000 Gallons; STB 760 Date 8-30-98

Pump Tank: _____ Gallons; PT _____ Date _____

Pump Make: _____ Model _____ Serial No. _____

Nitrification Field: No Fields 1 Square Feet 1080 Linear Feet 360

No Lines FOUR Trench Width 36" Max Trench Bottom Depth 28" Gravel Depth 12"

☑ New System ☐ Repair System Type: I, II, III, IV, V, VI

System Description: CONVENTIONAL GRAVITY

Repair System Description: CONV. GRAVITY

Maintenance Agreement Required: ☐ Yes ☑ No

☐ House/Mod. Home ☑ Mobile Home ☐ Business ☐ Other

No. Bedrooms 3 No. Bathrooms 2 No. Employees ____


☐ Slab ☑ Crawl Space ☐ Basement w/plumbing ☐ Basement wo/plumbing

Water Supply: ☐ Individual ☑ Public ☐ Community


Comments:/Conditions: INSTALL FOUR 3'x90' LINES ON CONTOUR AS SHOWN, NO DEEPER THAN 28" USING DROP BOXES FOR SERIAL DISTRIBUTION

Comments:/Conditions:

INITIAL SITE SKETCH SCALE: 1" = 40'

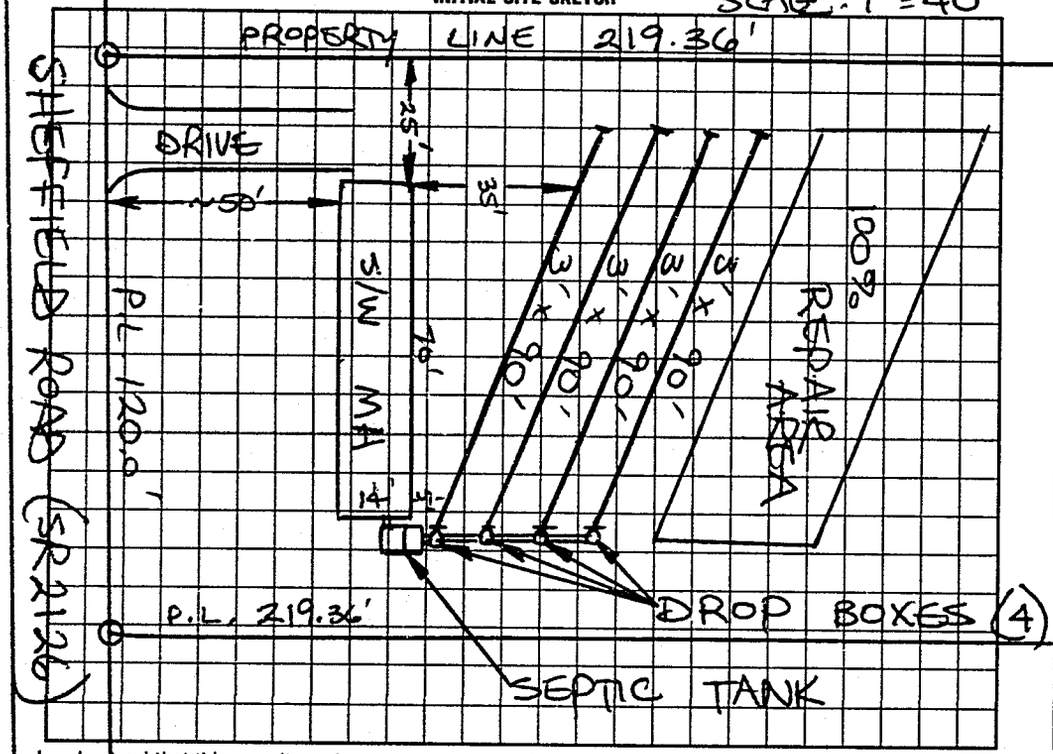

AS BUILT SKETCH

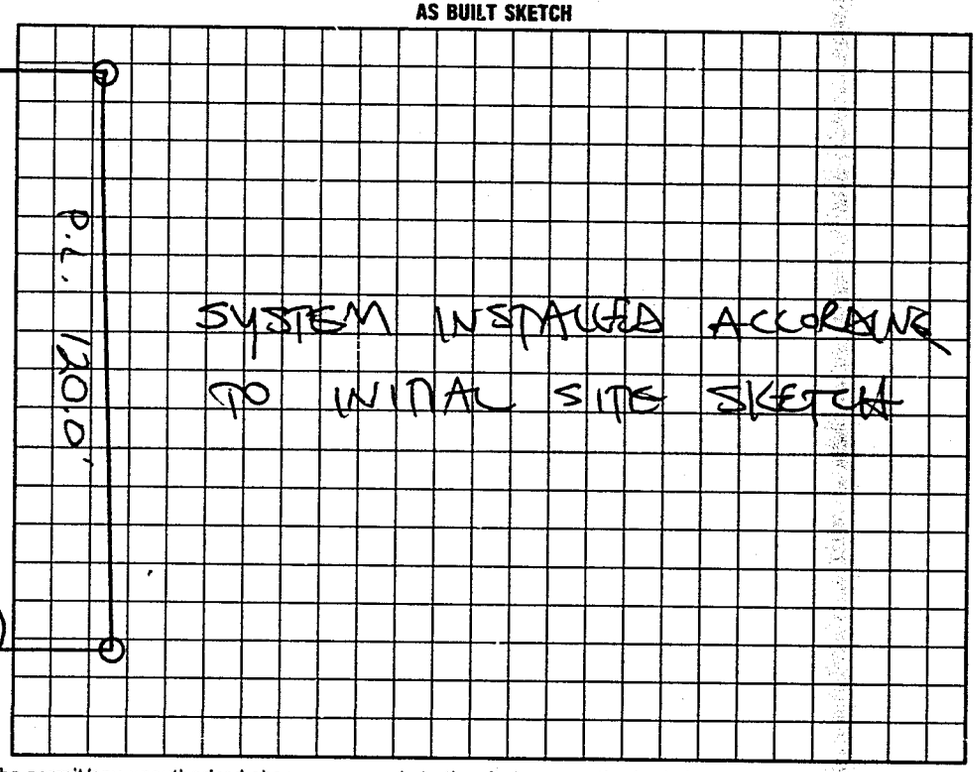

I understand that this permit can be suspended or revoked if any false information is supplied toward securing the permit/any unauthorized changes are made to the site/any unauthorized changes are made in the installation of the system. Improvement Permit with plat valid without expiration. Improvement Permit with site plan valid for sixty months. Authorization to Construct is valid for a period equal to that of Improvement Permit – not to exceed sixty months.

Signed: Joe Dillard date 8-3-98 Installed by: DONALD LAKEY

Improvement Permit by: STEVE HEDRICK date 7-31-98 Operation Permit by: STEVE HEDRICK date 11-5-98

Authorization to Construct by: STEVE HEDRICK date 7-31-98 Existing System Inspection by: _____ date _____

HEALTH DEPT COPY WHITE INSPECTION COPY (FINAL) GREEN OWNER COPY (FINAL) YELLOW INSPECTION COPY (INITIAL) PINK OWNER COPY (INITIAL) GOLD

8 5 0 1 0 0